

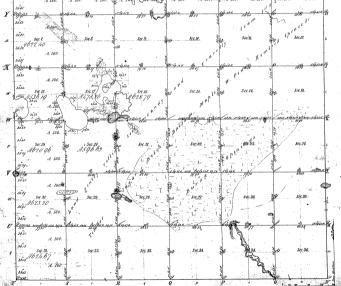

ĺ	Posts Courses deste.	Posts Courses Och	Butte Courses Of Chi
- 1			
- 1			
- 1	3 " #		
- 1	San		
i		1.	
		1	
- 1			
	İ		
			accept to the extra
		1	
		1	
		1	
			į.
		L	
	and the second	1	
		Į.	
		1.	
		1	
		1	
			l
	Manden Smile	Stel other	
		[J
		1 .	
			I amount to the second
			1
/		1	
*4		1	
		Lance Contract	1
			I
		_1	1
			5
l	1.0		
		T	
		T	
		1	1
			1
		1 1	
		1	1
		1	1
			1
			lana.
		-	1

					- 27	. 4
Total .	number	of z	teres.	226	50.8	9
					A 2 2 2 4 4 4	

197	Z. Zezignazza	Di Dana Suriesa	James IV contract	Total II SHITE	where San ray to	the fur! Gen!" acc.	16
900	Township lines	West Burt	Abril 18 1841	11: 78:19			
		Ger H.Cannen		64 34- 45		Secretary Secretary	of the


Leander likapman