36-3

# Township No. 49 N. Range No. 12 W. Mer. Mich.

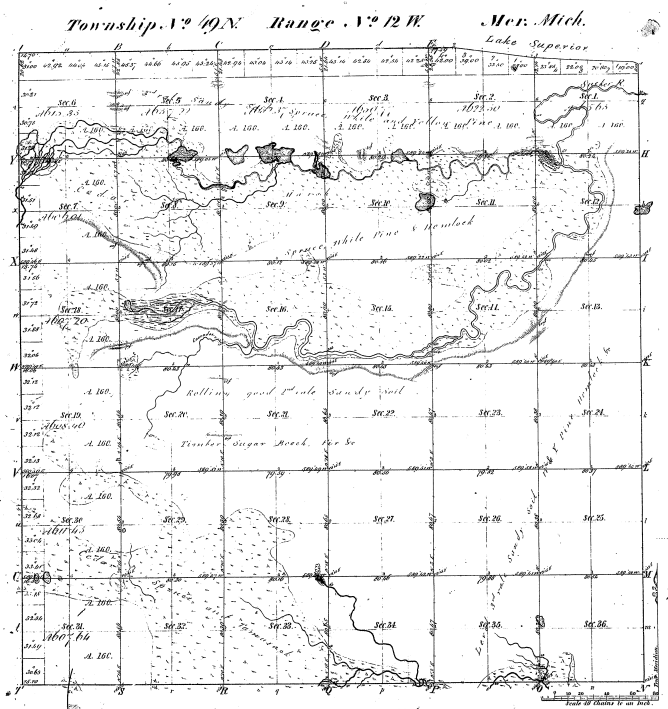


| Meanders of | | | | | | | | |
|---|---|---|---|---|---|---|---|---|
| Posts | Courses | Ch. Lk. | Posts | Courses | Ch. Lk. | Posts | Courses | Ch. Lk. |
| | | | | | | | | |

36-3

Total number of Acres 22804.65

| Surveys Designated | By Whom Surveyed | Date of Contract | Amount of Surveys | When Surveyed | When pd. for and ch. to the Inv. Gen. Ld. Ofc. |
|---|---|---|---|---|---|
| Township lines | W. A. Burt | April 1841 | M. Ch. Lks. 65 . 46 | 3rd Quar. 1841 | |
| Subdivisions | Francis Coleman | April 9 1851 | 61 . 56 . 88 | 2nd & 4th Quars. 1851 | |

The above Map of Township No. 49 North of Range No. 12 West of the Principal Meridian Michigan is strictly conformable to the field notes of the survey thereof on file in this Office, which have been examined and approved.

Surveyor General's Office,
Detroit Mich. 8th 1852

Charles Noble
Spec. Genl.