Township No. 50 N. Range No. 8 W. Mer. Mich.

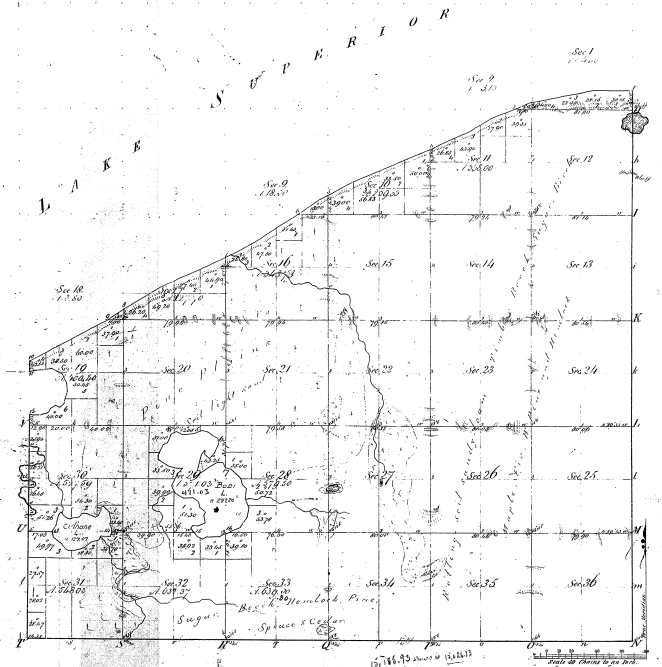

Meanders of									
Posts	Courses	Ch. Lk.	Posts	Courses	Ch. Lk.	Posts	Courses	Ch. Lk.	
3									

35-4

Total number of Acres 15,186.93 Sums to 15,186.73

Surveys Designated.	By Whom Surveyed.	Date of Contract.	Amount of Surveys M.	Ch.	Lk.	When Surveyed.	When Charged in the Surv. Genl's Acct.
Township lines	Wm. A. Birch	June 15th 1840	11	09	35	3rd Quar. 1840	
Subdivisions	Wells Burt	April 26. 1850	53	69	57	3rd Quar. 1850	

The above Map of Township No. 50 North & Range No. 8 West of the Principal Meridian (Michigan) is strictly conformable to the field notes of the survey thereof on file in this Office, which have been examined and approved.

Surveyor Generals Office,
Detroit, June 13. 1851

Charles Hobbs
Sur. Genl.