36-36

Township No. 42 N. Range No. 12 W. Mer. Mich.

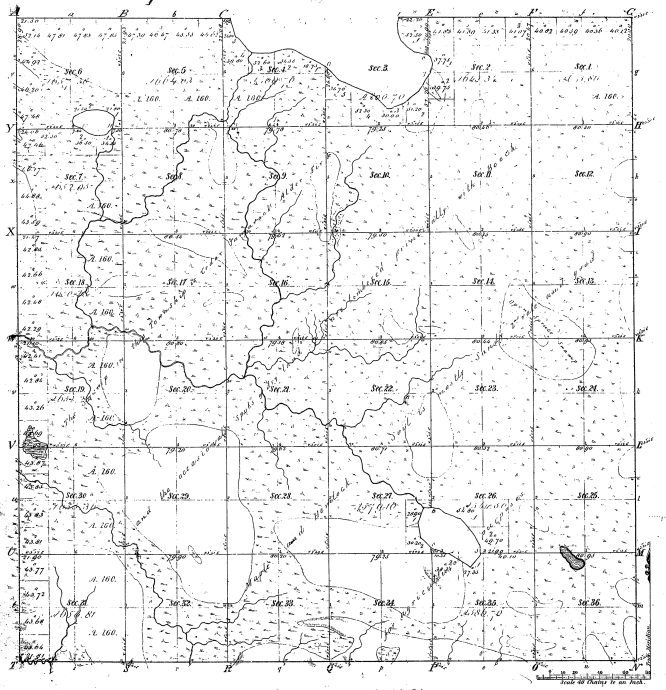

Meanders of								
Posts	Courses	Ch. Lk.	Posts	Courses	Ch. Lk.	Posts	Courses	Ch. Lk.

Meanders to Outlet Of Chain Of Lakes

Total number of Acres 22392.94

Surveys Designated	By Whom Surveyed	Date of Contract	Amount of Surveys	When Surveyed	When Sup.d for and ch.d to the Sur.r Gen.l asc.d
Township lines	John Burt	Feb. 26. 1845	M. Ch. Lks. 71 01 81	3rd Qu.r 1845	
Subdivisions	Guy H. Cadelon	July 14. 1849	65 50 81	3rd Qu.r 1849	

The above Map of Township No. 42 North of Range No. 12 West of Principal Meridian Michigan is strictly conformable to the field notes of the survey thereof on file in this Office, which have been examined and approved.

Surveyor General's Office,
Detroit April 15. 1850.

Charles Noble
Sur.r Gen.l