


Township N^o 43 N. Range N^o 1 W.

Mer. Mich.

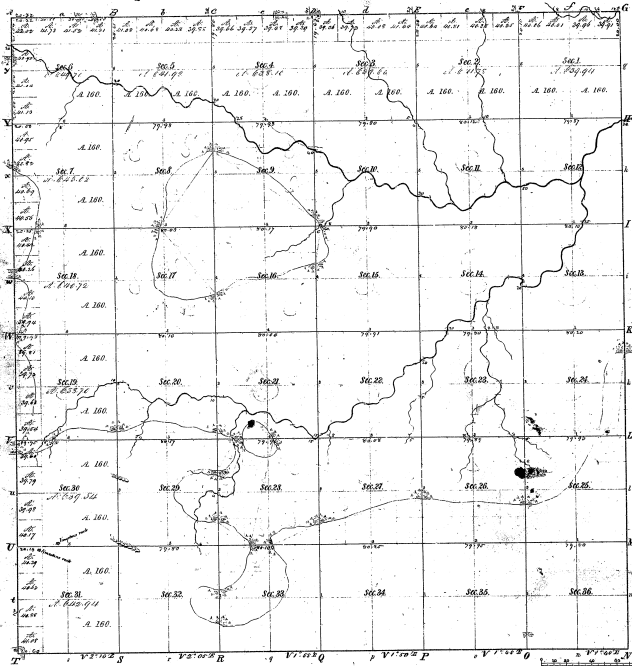


33-40

33-40

Total number of Acres. 23,655.96				
Survey Designated	By Whom Surveyed	Date of Original	Amount of Survey	When Made and by Whom
Township Area	J. H. Child	Sept. 27, 1866	36.00.00	1866
Subdivisions	J. H. Child	April 28, 1867	66.00.00	1867


Surveyors General Office
Michigan, Sept. 19, 1865
L. C. Case, Gen. Secy.