


Ship No III North Range N° XIV East of Meridian Michigan Territory

109

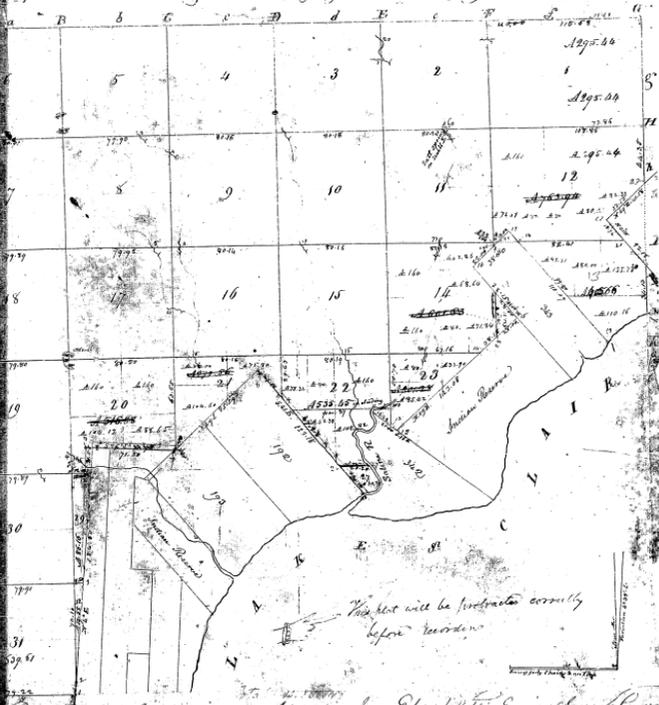


Proceeded to a contract with and instructions from Edward H. Fox Esquire Surveyor General of the United States bearing date 20th day of November 1816 I had admission and laid out and surveyed the above described Fractional Township and hereby certify that it had such marks as records bear, and that are referred to as are represented on said plat and described in the field as made first and compared with this plat into the Surveyor General's Office. Given at St. Louis the 20th day of January 1818  
 William Preston

26-38

26-38

