


Township N. IV North, Range N. XIII East of Mer. (Africa Ter.)

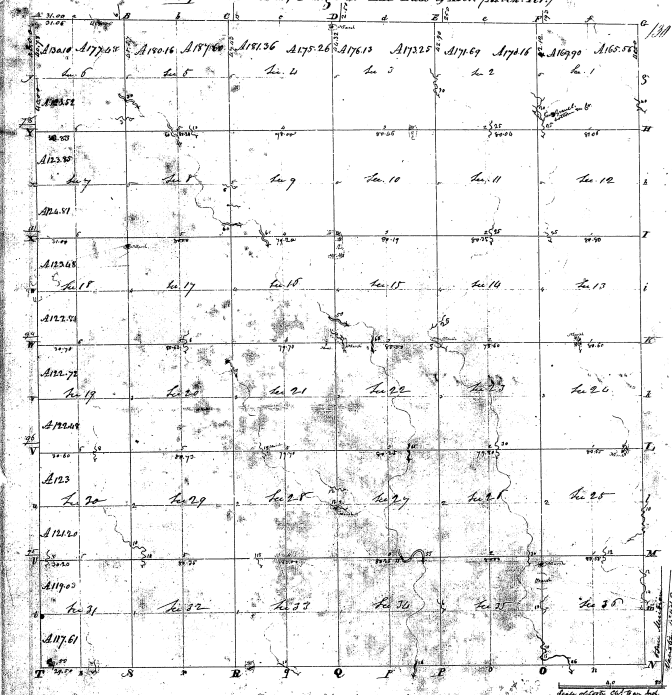

26-31

26-31

Pursuant to a Contract with and Instructions from Edward Tiffin, Esquire Surveyor General of the United States having date the twentieth day of November 1816 I have adversarially laid out and surveyed the above described Township; and do hereby certify that it had such marks and bounds both natural and artificial as are represented on said plat and records in the field through thereof and returned with the Plat into the Surveyors Office bearing this 22th day of Sept: 1817.

William Preston, Esq.