


Township N. V North Range N. XII East of Mer. (Mich. Ter)

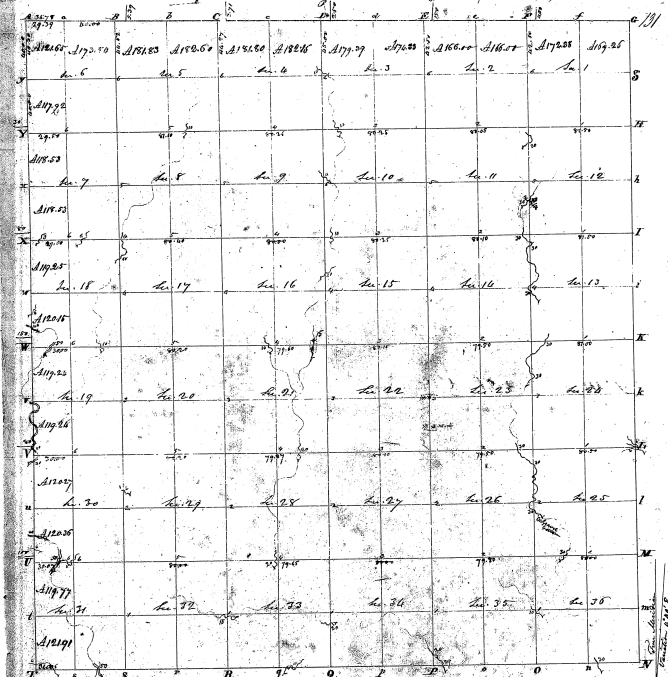

26-30

26-30

Pursuant to a contract with said Instructions from Colonel Jeffrey Rogers, Surveyor General of the United States, bearing date the twentieth day of November 1816 I have advanced laid out and surveyed the above town of Newshole; and do hereby certify that it had such marks and bounds both natural and artificial as are upon the said Plat and described in the said notes made thereon and returned with the Plat into the Surveyor General's Office bearing date the 23rd day of Sept. 1817.

William Brown, Jr.