


182



26-29

Pursuant to a Contract with and instructions from Edward Tiffin Esquire Surveyor General of the United States bearing date the twentieth day of November 1816 I have accompanied land and surveyed the above described township; and do hereby certify that it had such marks and bounds both natural & artificial as are so recorded as said Plat and described in the field notes made thereof and returned into the Surveyor General's Office. Certified this 25th day of September 1817.

Wm. H. Riddle

Township N<sup>o</sup> V North Range N<sup>o</sup> XIV East of the Mer. of Michigan Territory

122

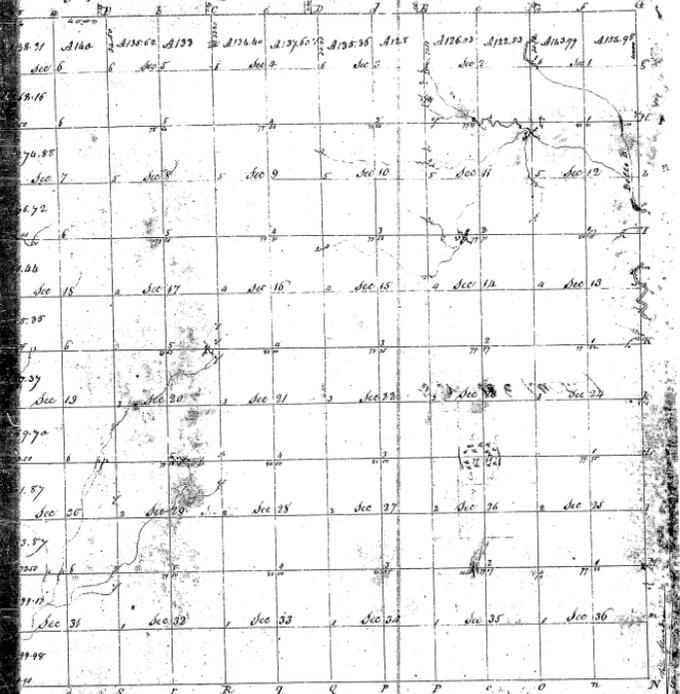

26-29

26-29

