38-32

Township No. 42 N Range No. 24 W Mer. Mich.

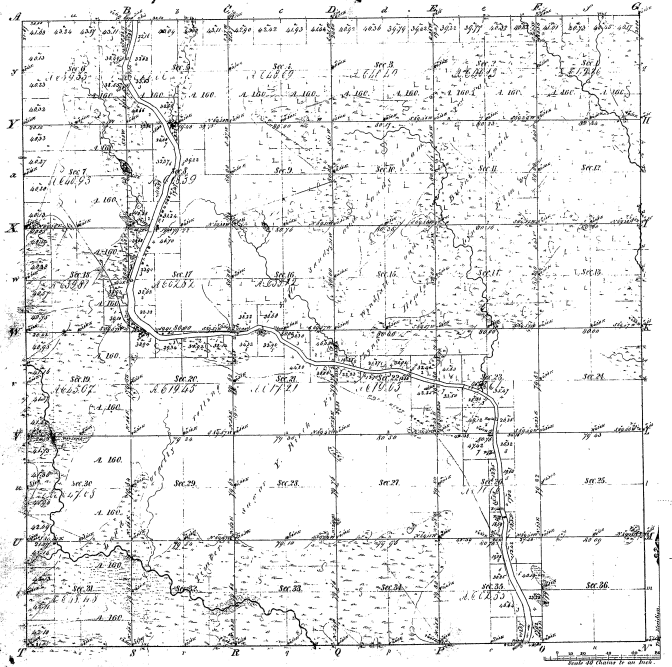

Meanders of							
Posts	Courses	Ht. Lbs.	Posts	Courses	Ht. Lbs.	Posts	Courses	Ht. Lbs.

38-32

Man. 18 Feb. 78

Total number of Acres 23,001.67

Surveys Designated	Op. When Surveyed	Date of Contract	Amount of Surveys	When Surveyed	When Sur. Gen. and ch. in the Sur. Gen. Ser.
Township lines	Douglas Houghton	June 21st 1846	M. 04 Ch. 00 Lk. 00	4th Quar. 1844	
Subdivisions	E.C. Martin	Bond Oct. 5 1857	78 60 13	3d Quar. 1852	
S.B.	John Burt	Sept 7 1846	6 01 05	2nd Quar. 1846	

The above Map of Township No. 42 N. of Range No. 24 W. of the Principal Meridian of Michigan is strictly conformable to the field notes of the survey thereof on file in this Office, which have been examined and approved.

Surveyor General's Office
Detroit Michigan 8 1853

Leander Chapman
Sur. Gen.