38-17

Township No. 44 N. Range No. 25 W. Mer. Mich.

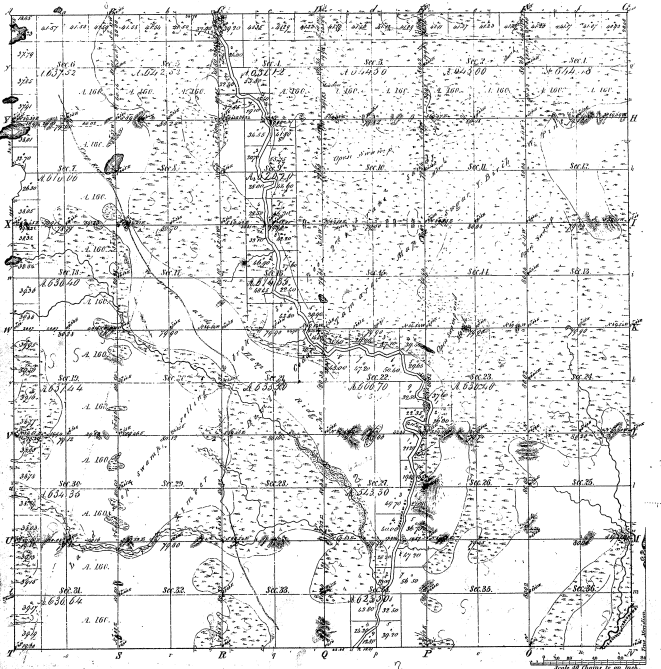

Total number of acres 22,800.05

Surveys Designated	By Whom Surveyed	Date of Contract	Amount of Surveys	When Surveyed	When & how and what in the Surv. Gen.'s own?
Township Lines	Theophilus Houghton	March 25 1836	M. Oct. 31 1836	1st Quarter 1837	
Subdivisions	Marlow Wright	Oct. 31 1836	April 30 1837		

The above Map of Township No. 44 North of Range No. 25 West of the Principal Meridian of Michigan is strictly conformable to the field notes of the survey thereof on file in this Office, which have been examined and approved.

Surveyor General's Office
Detroit 12 August 1839

Lander Chapman
Surv. Gen.l