38-14

Township N.º 45 N. Range N.º 27 W. Mer. Mich.

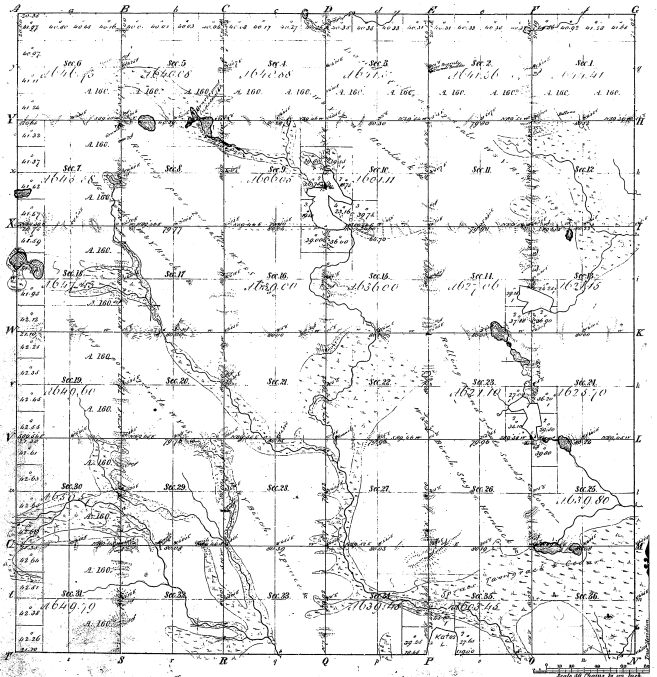

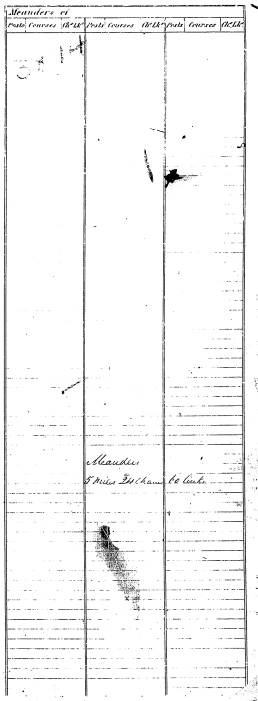

Total number of Acres 22917.67

Surveys Designated	By Whom Surveyed	Date of Contract	Amount of Surveys	When Surveyed	When the Plat was returned to the Surr. Gen.ls Office
Township lines	Wallace & Scudder Surr.	Sept.r 7 1847	M. 0 Ch. 0 Lks. 0	2nd Quar. 1847	
Subdivisions	John Burch	April 26. 1848	63	2nd Quar. 1848	
Field notes by	D. Heyngton	June 25 1848	6 80 92	4 Quar. 1848	

The plow Maps of Township N.º 45 North of Range N.º 27 West of the Principal Meridian Michigan is strictly conformable, to the field notes of the survey thereof, now in the Office, which have been examined and approved.

Surveyor Generals Office
Detroit June 15 1851

Charles Noble
Surr. Gen.