


Township N^o 46N. Range N^o 24W.

Mer. Mich.

34


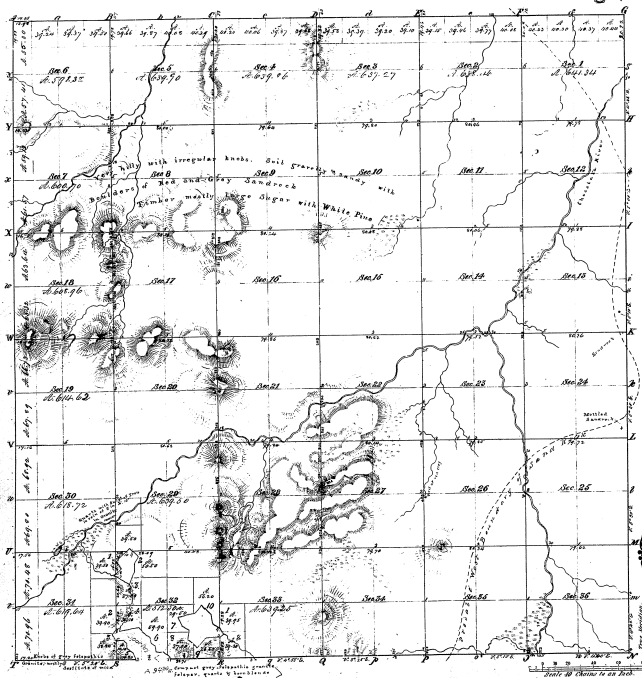


39-35




