Township No. 46 N. Range No. 29 W. Mer. Mich.

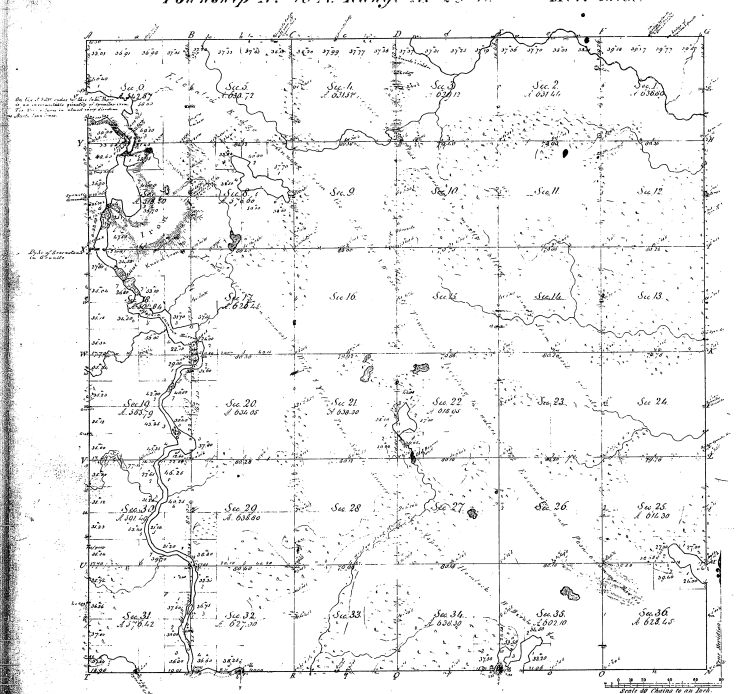

Meanders of

Pass.	Contract	Ch.	Lk.	Pass.	Contract	Ch.	Lk.	Pass.	Contract	Ch.	Lk.

Total meanders 21 miles 64 ch. 89 lks

Total number of Acres 22,371.90

Surveys Designated.	By Whom Surveyed.	Date of Contract.	Amount of Surveys N. Chs. Lks.	When Surveyed.	When Charged to the Surv. Genl. Acct.
Township lines.	Wm. C. Austin Cond.	Sept. 7 1846	11. 78. 43	3d. yr. 1846	
Subdivisions.	Harvey Mellen	Band 13d Dec 1846	80. 33. 99	3d. yr. 1846	

The above Map of Township No. 46 North of Range No. 29 West of the Principal Meridian, Michigan is strictly conformable to the field notes of the survey thereof on file in this Office, which have been examined and approved.

Surveyor General's Office.
Detroit, January 27 1849.

Lucius Lyon, Surv. Genl.

45-20