


Township N^o 47 N. Range N^o 23 W. Mer. Mich.

Lake Superior.

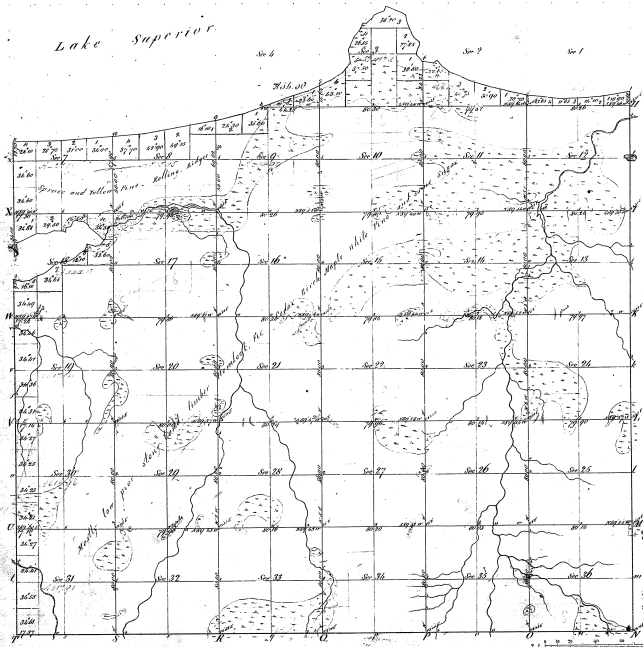

Shaded in

39-34

39-34

9 11 27

Total number of acres 10,232.68


This above Map of Township N^o 47 N. Range N^o 23 W. Mer. Mich. is a true and correct copy of the original as the same was filed in the office of the Surveyor General of Michigan on the 17th day of July 1852.

Surveyor General's Office
 Charles C. Chapman, Secy.