Township No. 48 N. Range No. 29 W. Mer. Mich.

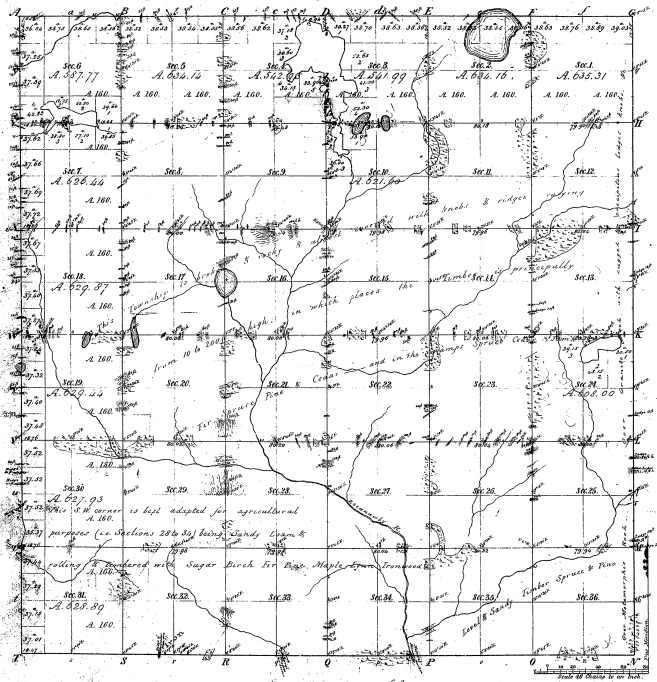

Meanders of								
Posts	Courses	Ch. Lks.	Posts	Courses	Ch. Lks.	Posts	Courses	Ch. Lks.

45-12

Total number of Acres 22668.49

Surveys Designated	By Whom Surveyed	Date of Contract	Amount of Surveys	When Surveyed	When pd. for and ch'd. to the Surv. Gen'l. acc't.
Township lines	Wm. A. Sabin & Austin Bart.	Sept. 7 1846	M. 11 Ch. 22 Lks. 52	Sept. 9 1846	
Subdivisions	Wells Burt	Bond Feb. 26 1849	66 44 68	8th Jan. 1848	

The above Map of Township No. 48 North of Range No. 29 West of the Principal Meridian Michigan is strictly conformable to the field notes of the survey thereof on file in this Office which have been examined and approved.

Surveyor General's Office
Detroit, Mich. 8 1849

Lucius Lyon, Surv. Genl.

Comd. Copy made
Dr. Jackson copy made
Digitized Copy made