Township N°49 N. Range N°26 W. Her. Mich

39-23

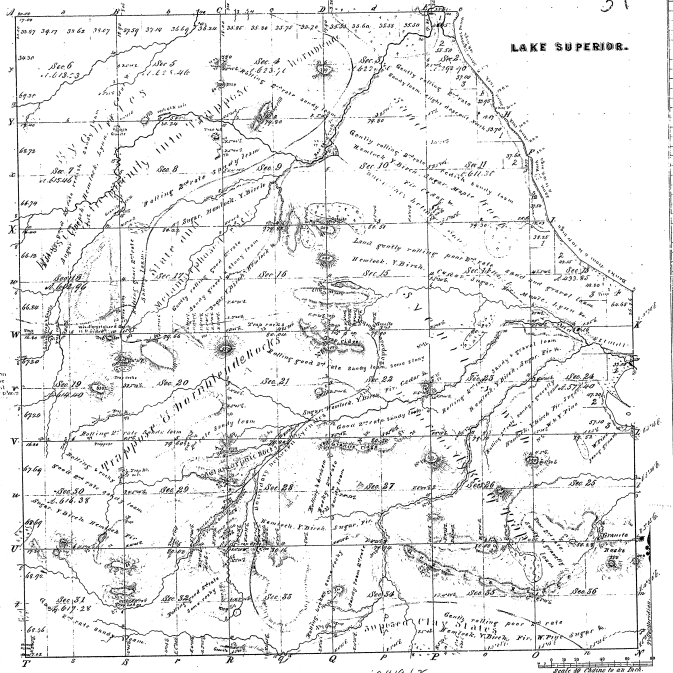

Meanders of							
Public Contracts	Vol.	Page	Public Contracts	Vol.	Page	Public Contracts	Vol.	Page

39-23

The Exterior Lines are shewn thus: Those Red thus: The Contracted Lines thus: Those Yellow thus:

21 32 chains East on 2nd Std. Latitude 46°53'. Total number of Acres 21172.28

Surveys brought into the Office.	By Whom Surveyed.	Date of Contract.	Amount of Surveys At Old Rates.	When Surveyed.	When Changed in the Mer. Basis and Rates.
Township Lines.	Wm. H. Forrest	June 25 1838		1st Qr. 1845	
Subdivisions.	Richard U. Sims	Sept 7th 1846	60. 53. 33	3rd Qr. 1846	

The above Map of Township One 49 North of Range One 26 West of the Principal Meridian, Michigan, is strictly conformable to the field notes of the survey thereof on file in this Office, which have been examined and approved.

Surveyor Generals Office, Detroit, March 29 1847

Lucius Lyon, Surv. Genl.