39-6

Township No. 52 N. Range No. 29 W. Mer. Mich.

39.0

Meanders of							
Path	Courses	Ch. & Lks.	Path	Courses	Ch. & Lks.	Path	Courses	Ch. & Lks.

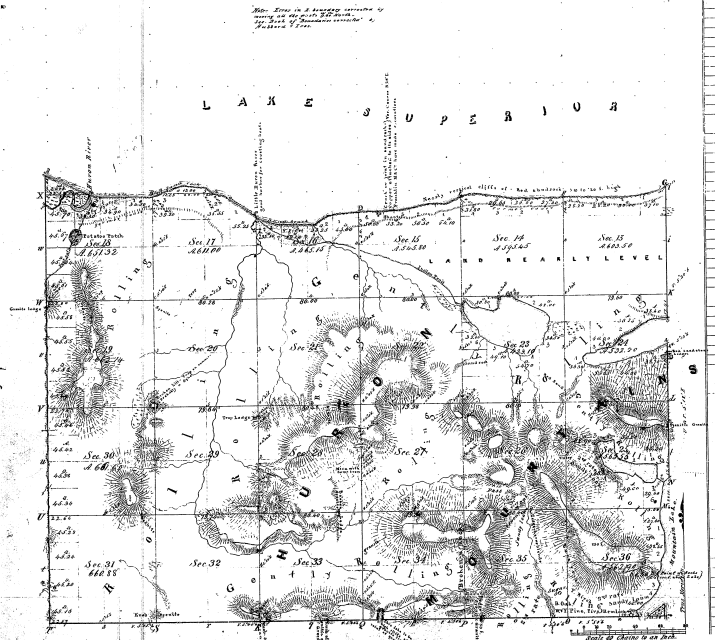

Total Number of Acres 14 Chs. 79

Survey Designated	By Whom Surveyed	Date of Contract	Amount of Survey M.	Ch.	Lks.	When Surveyed	Ch.	Lks.	When Charged on the Surr's Gen'l Ledger
Township lines	[illegible]	June 25 1846	5	28	08	[illegible]			
Subdivisions	[illegible]	Sept 7 1846	32	26	97	[illegible]			

The above Map of Township No. 52 North of Range No. 29 West Principal Meridian, Michigan, is strictly conformable to the field notes of the survey thereof on file in this Office, which have been examined and approved.

Surveyor General's Office,
Detroit June 11 1847

Lucius Lyon, Sur. Genl.