


Map No. 17-16
M. J. King

Township N^o 17 N., Range N^o 16 West Mex: 6 West

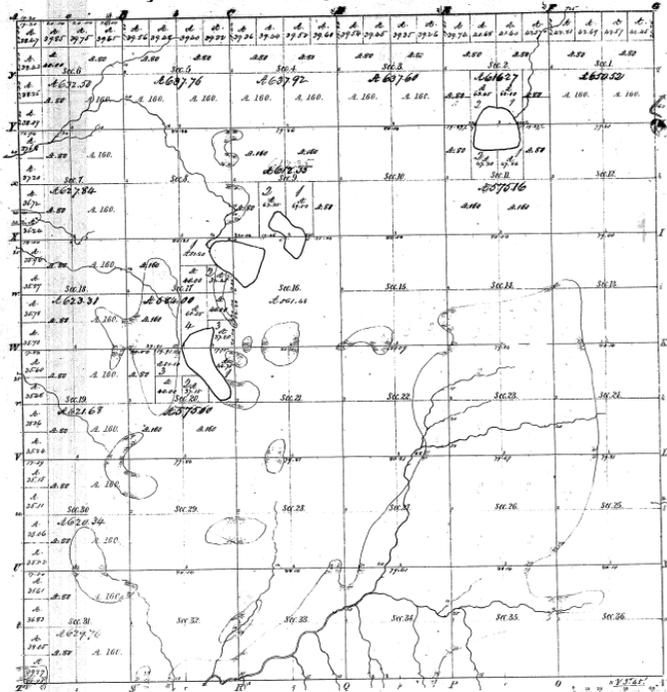

Boundaries of Section

10-16

Total number of acres 33,662.247			
Survey designated	By whom surveyed	Date	Amount of Acres


Surveyor General's Office
 Cincinnati, Feb. 28, 1829
P. Reading Sec'y.