Township N.o 17 N., Range N.o 14 West Mer: (Mich.)

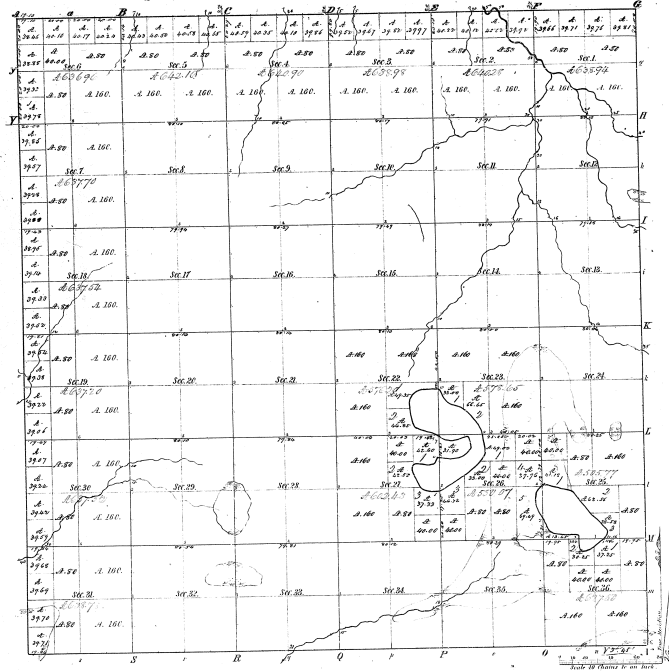

Scale 40 Chains to an Inch.

Meanders of the East Peak's Courses	Dist.s	Peak's Courses	Dist.s	Peak's Courses	Dist.s
Lake in Sections 25, 30 & 36.					
4. S 80 E	26.60				
S 24 E	14.50				
S 43 E	32.00				
1. S 21 W	7.00				
S 52 W	18.00				
N 78 W	8.00				
2. S 84 W	10.00				
S 71 W	3.00				
N 76 W	20.50				
3. S 89 W	18.50				
S 72 W	13.00				
S 57 W	2.00				
4. S 32 E	9.00				
Lake in Sections 22, 23, 26 & 27.					
10. S 28 E	14.00				
S 60 E	10.00				
5. S 80 E	28.17				
E 8 0	18.00				
N 64 W	17.00				
6. N 60 W	20.00				
N 52 W	18.00				
N 28 W	14.00				
N 37 E	17.00				
9. N 76 E	8.00				
N 52 E	18.00				
N 11 W	18.00				
N 38 E	14.00				
12. East	18.37				

Total number of Acres 23017.38

Surveys Designated	By Whom Surveyed	Date of Contract	Amount of Surveys	When Surveyed	When the Lines and Offices were Accepted
Township lines	John Mullett	July 17th 1837	24 - 00 - 00	5th Sept 1838	3rd Dec 1838
Subdivisions	Wm. Talbot Edgerton	July 16. 1838	165 - 76 - 16	4th Dec 1838	1st Jan 1839

The above Map of Township 17 N. of Range 14 W. of the Principal Meridian, Michigan, is strictly conformable to the field notes of the survey thereof on file in this Office, which have been examined and approved.

Surveyor Generals Office
Cincinnati, February 20th 1839

S. S. Lee Surv.r Gen.l