



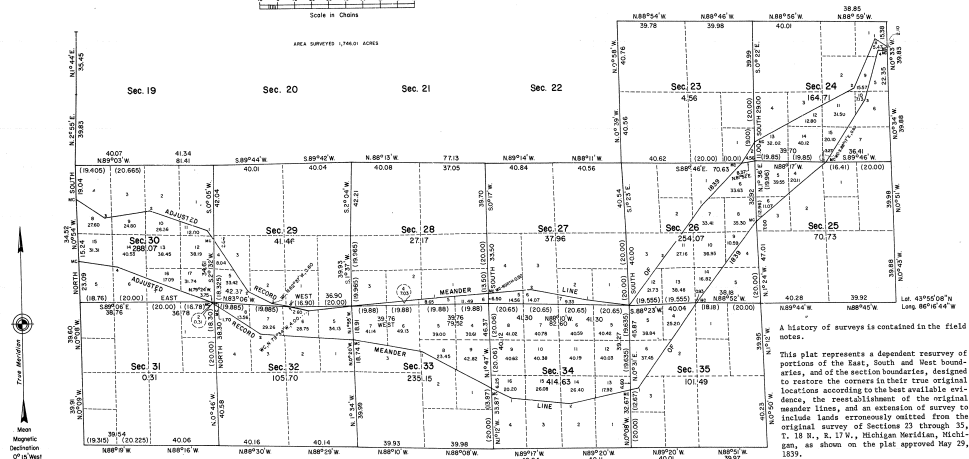

TOWNSHIP 18 NORTH, RANGE 17 WEST, OF THE MICHIGAN MERIDIAN, MICHIGAN

DEPENDENT RESURVEY AND SURVEY

 

POINT	Bearing	Dist.	POINT	Bearing	Dist.
N. MC, 819 & 824	N. 58°51' W.	8.31	S. MC, 825 & 830	S. 81°17' E.	21.97
AP1, 824	S. 38°54' W.	30.18	ADN, 830	S. 69°17' E.	57.56
AP2, 824	S. 63°04' W.	65.44	MC, 830 & 831	S. 57°04' E.	4.40
MC, 823 & 824	S. 34°11' W.	16.73	MC, 831 & 832	S. 37°18' E.	31.29
MC, 823 & 826	S. 45°31' W.	33.83	AP3, 832	S. 84°14' E.	53.53
AP1, 826	S. 38°49' W.	36.79	MC, 832 & 833	S. 79°27' E.	41.36
AP2, 826	S. 40°15' W.	34.79	AP1, 833	S. 63°44' E.	44.35
S27 826			MC, 833 & 834	S. 66°28' E.	14.15
S28 826			AP1, 834	S. 84°58' E.	24.27
AP1, 827	N. 78°24' W.	33.19	AP1, 834	N. 78°39' E.	34.35
AP2, 827	S. 88°44' W.	25.38	MC, 834 & 835	N. 61°00' E.	4.85
MC, 827 & 828	S. 88°54' W.	31.84	AP1, 835	N. 37°18' E.	58.38
AP1, 828	S. 84°56' W.	25.93	MC, 828 & 835	N. 38°41' E.	59.22
S29 828			MC, 825 & 826	N. 04°29' E.	54.14
S32 828			MC, 824 & 825	N. 33°17' E.	41.74
AP1, 832	S. 84°57' W.	47.05	AP1, 826	N. 17°11' E.	38.92
AP1, 832			AP4, 824	S. 88°04' E.	4.35
MC, 829 & 832	N. 79°34' W.	12.16			
AP1, 829	N. 79°13' W.	10.54			
AP1, 829	N. 82°31' W.	15.69			
AP1, 829	N. 28°17' W.	34.70			
MC, 829 & 830	N. 25°11' W.	8.18			
AP1, 830	N. 70°26' W.	34.68			
AP2, 830	S. 82°02' W.	26.84			
AP3, 830	N. 40°58' W.	19.90			
N. MC, 825 & 830					

UNITED STATES DEPARTMENT OF THE INTERIOR  
BUREAU OF LAND MANAGEMENT  
Washington, D. C. September 22, 1978

This plat is strictly conformable to the approved field notes, and the survey, having been correctly executed in accordance with the requirements of law and the regulations of this Bureau, is hereby accepted.

For the Director

*Bernard W. Johns*

Chief, Division of Cadastral Survey

A history of surveys is contained in the field notes.



The position of the original meander courses of Pere Marquette Lake is shown by two irregular lines with numbered angle points. These lines as originally reported were grossly in error, and have therefore been marked as "line boundaries", with the directions and lengths of the several courses adjusted to the reestablished position of the original survey.

Except as shown hereon, the lottings and areas are as shown on the plat approved May 29, 1939.

These surveys were executed by Barry G. Krebs, Cadastral Surveyor, from May 5 through September 3, 1974, under Special Instructions for Group No. 75, Michigan, dated April 30, 1974.

9-6 (2)