Township No. 19 N. Range No. 17 West Mer. of Mich.

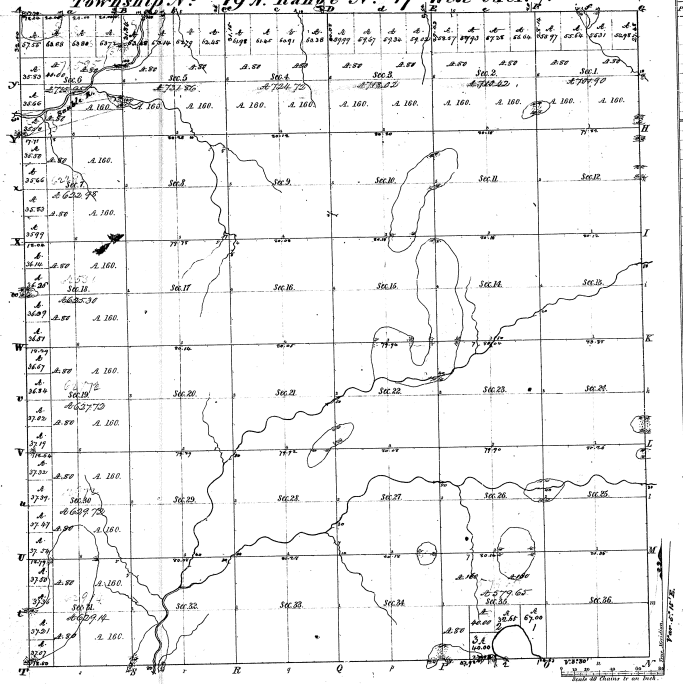

Meanders of part of a Lake in Sections 35.

Posts	Courses	Chains	Posts	Courses	Chains	Posts	Courses	Chains
1.	N 73 W.	6.00						
	N 37 W.	7.00						
	N 22 W.	12.00						
	N 28 W.	14.00						
	N 38 W.	8.00						
	N 52 W.	11.00						
	N 21 W.	8.00						
	N 7 W.	6.00						
	N 11 E.	8.00						
2.	N 45 E.	8.00						

Total number of Acres 23377.38.

Surveys Designated	By Whom Surveyed	Date of Contract	Amount of Surveys	When Surveyed	When the Lines and the Sub-Divisions were Established
Township lines	Alexander McLeod	July 19 1837	M. 24	52	2	2 of 1838	3 of 1838
Subdivisions	Lyle Sibley	July 16 1838	61	41	14	3	"	1 of 1839

The above Map of Township No. 19 N. of the 17 West Principal Meridian, Michigan, is strictly conformable to the field notes of the survey thereof on file in this Office, which have been examined and approved.

Surveyor Generals Office, Cincinnati, Dec. 8th 1839

P. P. Leary Surv. Gen.