


Township 1° 13' N., Range 1° 9' West Mich. (Mich.)

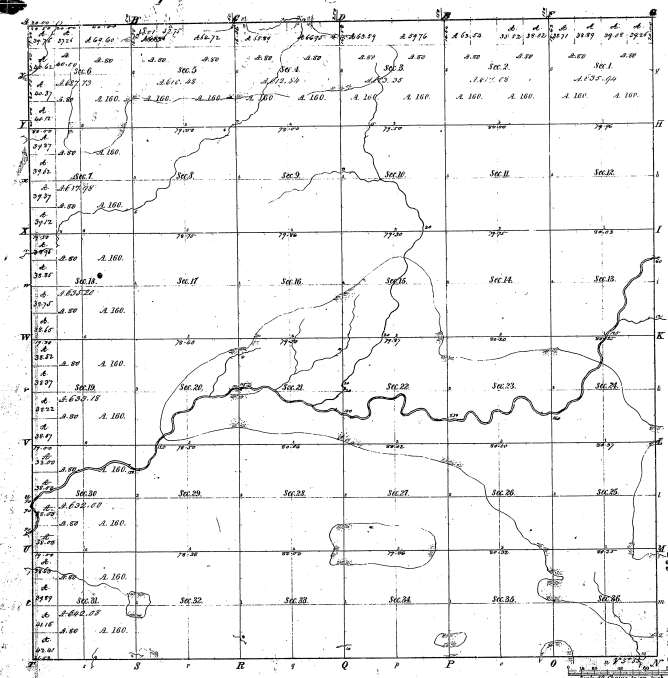


11-29

11-29

Total number of Acres 22,857.66

Survey Designated	By Whom Surveyed	Date of Contract	Amount of Survey	When Approved	When the Survey was Made
Township - Done	Wm. H. Rouse	1837	22,857.66	1837	1838
Subdivisions	W. H. Rouse	1837	22,857.66	1837	1838

The above Map of Township 1° 13' North of Range 1° 9' West of the Principal Meridian Michigan is hereby confirmed to the following of the survey thereof on file in this Office, which have been examined and approved.

Surveyor General's Office
Ann Arbor Mich. 24th 1839

W. H. Rouse