Township N.° 33 N. Range N.° 28 W. Mer. Mich.

47-28

Wisconsin.

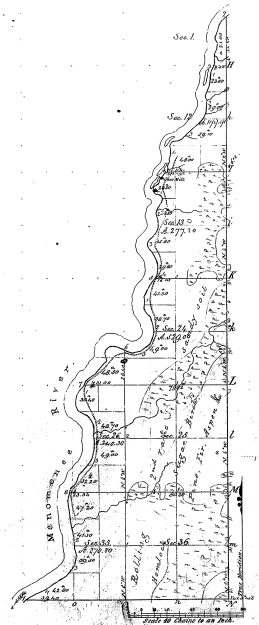

Meanders of								
Posts	Courses	Dist. Lks	Posts	Courses	Dist. Lks	Posts	Courses	Dist. Lks
47-28								
Total meanders by mile 79 ch. 00 lnk.								

Surveys Distinguished.	By Whom Surveyed.	Date of Contract.	Amount of Surveys M. Ch. Lks.	When Surveyed.	When Charged in the Surveyor's acct.
Total number of Acres 2,963.70					
Township lines	John Mullett	June 24. 1847	7 32 00	1st Qr 1847	
Subdivisions.	John Mullett	April 22. 1848	43 53. 42	3d Qr 1848	

The above Plat of Township N.° 33 N. of the Base Line, of Range N.° 28 W. of the Principal Meridian, Michigan, is strictly conformable to the field notes of the Survey thereof, on file in this Office, which have been examined and approved.

Surveyor General's Office
Detroit, Nov. 20, 1848.

Lucius Lyon, Surv.r Gen.l