47-23

Township No. 34 N. Range No. 25 W. Mer. Mich

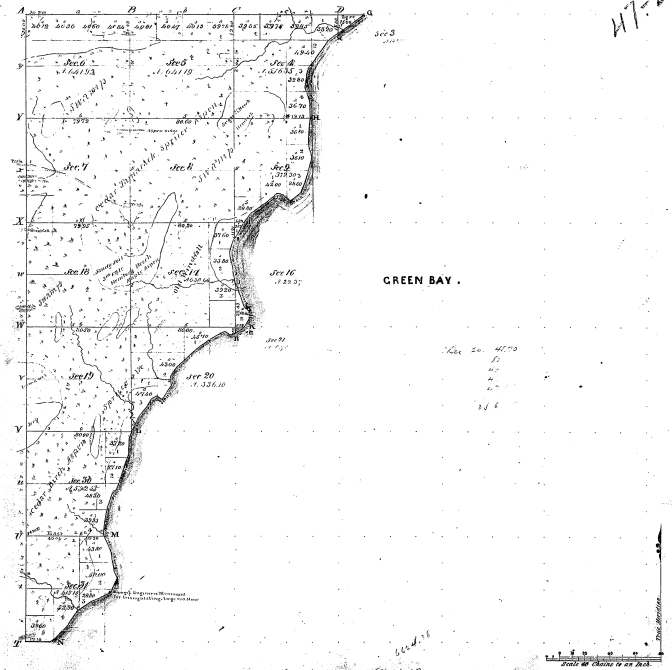

Meanders of								
Posts	Courses	Ch. Lks	Posts	Courses	Ch. Lks	Posts	Courses	Ch. Lks

Total number of Acres 67.04.38

Surveys Designated.	By Whom Surveyed.	Date of Contracts.	Amount of Surveys M. Ch. Lks	When Surveyed.	When Charged in the Surv. Genl's acct.
Township lines.	Nelson Mattell	1 Nov. 1847	17 10	2nd Qr 1847	
Subdivisions.	Nelson Mattell	April 28 1847	23 17 79	2nd Qr 1848	

The above Map of Township No. 34 North of Range No. 25 W. of the Principal Meridian, Michigan is strictly conformable to the field notes of the survey thereof on file in this Office which have been examined and approved.

Surveyor General's Office.
Detroit, Dec. 20. 1848.

Lucius Lyon, Sur. Genl.

Registered Copy