Township No. 34 N. Range No. 28 W. Mer. 4th.

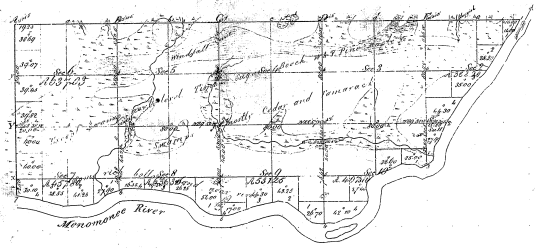

WISCONSIN

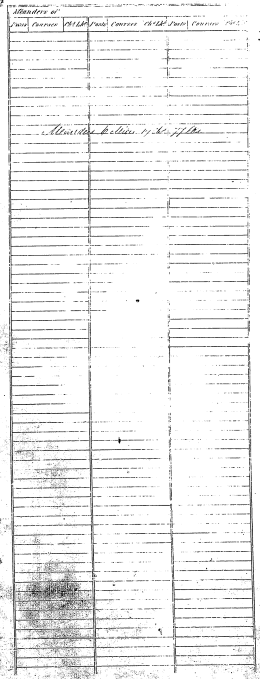

47-26

47-26

Scale 40 Chains to an Inch.

Total number of Acres 4770.58

Officers Name(s)	Date of Contract	Date of Survey	When Surveyed	When Plotted in the Surveyor Gen'l's Office
Township Lines:				
Subdivisions:				

The above Map of Township No. 34 North of Range No. 28 West of the Fourth Principal Meridian Michigan is strictly conformable to the field notes of the survey thereof, on file in this office, which have been examined and approved.

Surveyor Generals Office
Detroit October 2nd 1854

Surveyor General