47-17

Township No. 35 N Range No. 29 W Mer: Mich.

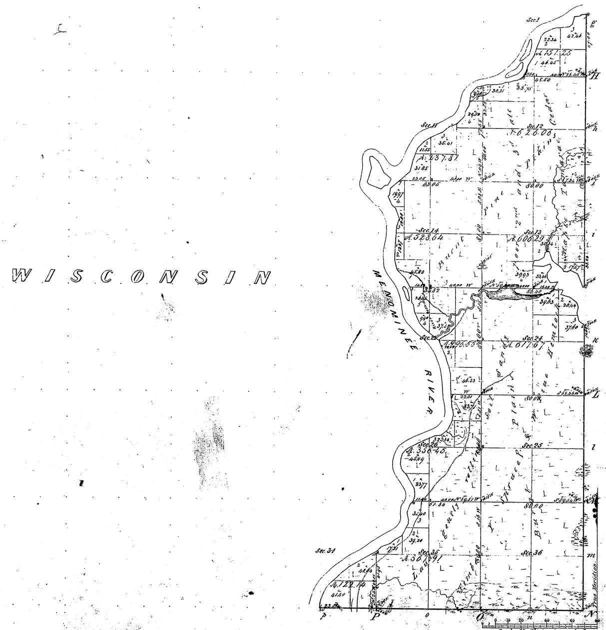

Meanders of								
Posts	Courses	Chs Lks	Posts	Courses	Chs Lks	Posts	Courses	Chs Lks
	Meanders 9 Miles 49 chs 10 Lks							

Total number of Acres 5390.77

Surveys Designated.	By Whom Surveyed.	Date of Contract.	Amount of Surveys. M. Chs Lks	When Surveyed.	When Charged in the Surr Genl's acc.
Township lines.	John Mullett	June 26th 1847	7 .. 62 .. 55	3d Quar. 1848	
Subdivisions.	Francis Coleman	Bond Nov 29th 1852	21 .. 61 .. 85	3d Quar. 1852	

The above Map of Township No. 35 N of Range No. 29 West of the Principal Meridian of Michigan is strictly conformable to the field notes of the survey thereof on file in this Office, which have been examined and approved.

Surveyor General's Office,
Detroit October 4th 1854.
Leander Chapman Surr. Genl.

16 14