


Township N. 37. N. Range. W. 25. W. Mer. Mech.

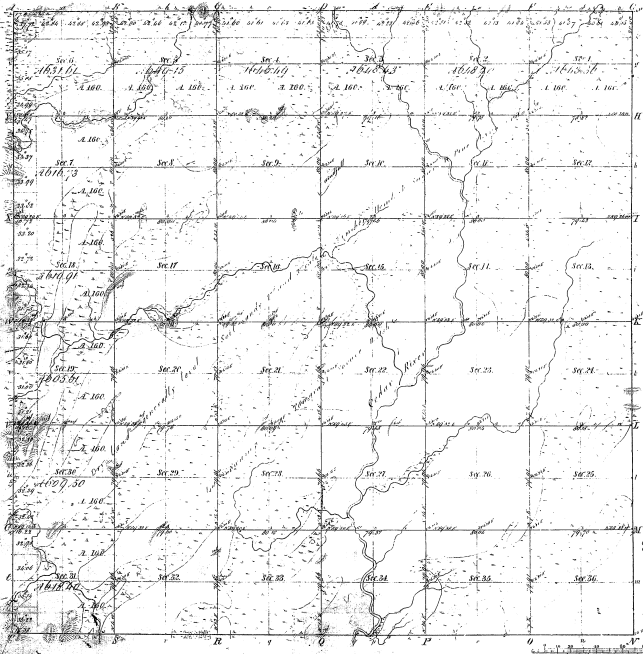

Wentworth's
 1854
 1855
H-9

47-9

Total number of Acres 22020 0/100

Tracts designated	By whom surveyed	Date of Certificate	Amount of Survey	When Surveyed	How far and at what distance from the Section line
Individually	Geo. H. Adams	March 2 & 1853	59. 60. 77	5 th June 1853	

The above Map of Township N. 37. N. Range. W. 25. W. Mer. Mech. is a true and correct copy of the original Survey of the above Township as shown on the map in the office of the Surveyor General's Office, and is hereby approved and attested.


Surveyor General's Office
 10th June 1855

Samuel Chapman
 Surveyor General

DUPLICATE ORIGINAL

TOWNSHIP 37 NORTH, RANGE 25 WEST, OF THE MICHIGAN MERIDIAN, MICHIGAN.
DEPENDENT RESURVEY

417-9

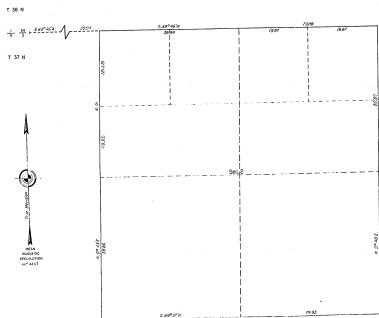

A history of survey is given on the field note record.
This plat represents the dependent resurvey of a portion of the land bearing and section 2, Township 37 North, Range 25 West, of the Michigan Meridian, Michigan, situated in section 2, corner to their two original sections according to the first subdivision.


UNITED STATES DEPARTMENT OF THE INTERIOR
BUREAU OF LAND SURVEY


This plat is hereby acknowledged to the approved said notes, and the survey, bearing, have correctly compared in accordance with the requirements of law and the regulations of this Bureau, to hereby accepted.

For the Director

W. F. Thompson

Chief Engineer, Bureau of Land Survey

