46-26

Township No. 39 N. Range No. 25 W. Mer. Mich.

Meanders of

Posts	Courses	Vis.	Lks.	Posts	Courses	Vis.	Lks.	Posts	Courses	Vis.	Lks.

46-26

Total number of Acres 23371.81

Surveys Designated	By Whom Surveyed	Date of Contract	Journal of Surveys	When Surveyed	When & on what pts. the Sur. Gen.l was asst.
Township lines	John Mullett	[illegible]	11 [illegible] 11	2nd [illegible]	
Subdivisions	Geo. K. Adams	Journal [illegible]	29 - 06 - 03	1st & 2nd Class 1862	

The above Map of Township No. 39 North of Range No. 25 West of the Principal Meridian Michigan is strictly conformable to the field notes of the survey thereof on file in this Office, which have been examined and approved.

Surveyor General's Office
Detroit July 18th 1863

Seneca Ghodman
Surv. Genl.

TOWNSHIP 39 NORTH, RANGE 25 WEST, OF THE MICHIGAN MERIDIAN, MICHIGAN.

DEPENDENT RESURVEY

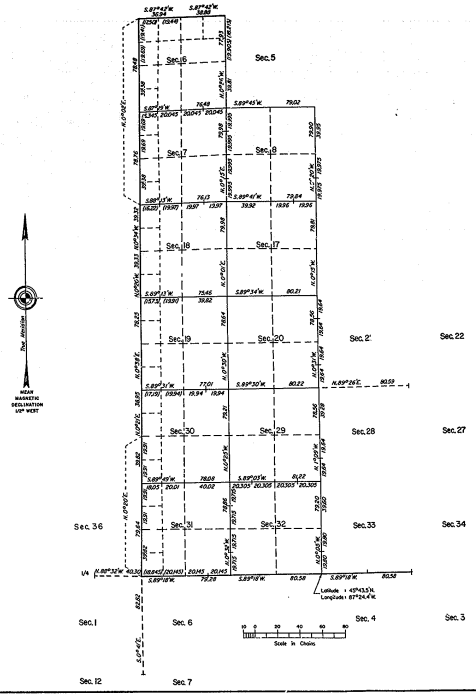

A history of surveys is contained in the field note record.

This plat represents the dependent resurvey of a portion of the south, west, and north boundaries, and a portion of the subdivisional lines designed to restore the corners in their true original locations according to the best available evidence, T. 39 N., R. 25 W., Michigan Meridian, Michigan.

The areas are as shown on the plat approved July 16, 1853.

Survey executed by Douglas V. Ritter, Cadastral Surveyor, beginning July 28, 1980, and completed July 10, 1981, pursuant to Special Instructions for Group 80, Michigan, dated July 21, 1980.

UNITED STATES DEPARTMENT OF THE INTERIOR
BUREAU OF LAND MANAGEMENT
Alexandria, Virginia December 23, 1982

This plat is strictly conformable to the approved field notes, and the survey, having been correctly executed in accordance with the requirements of law and the regulations of this Bureau, is hereby accepted.

For the Director

Chief Cadastral Surveyor
Eastern States Office

16-26