46-7

Township No. 40 N. Range No. 25 W. Mer. Mich.

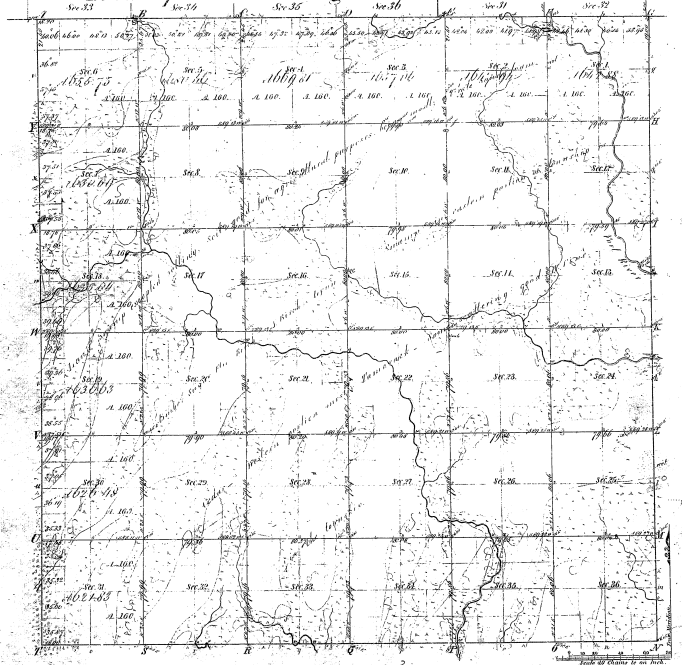

Meanders of

Prats	Courses	Ch. Lks.	Prats	Courses	Ch. Lks.	Prats	Courses	Ch. Lks.

Total number of Acres 22103.97

Survey Designated	By Whom Surveyed	Date of Contract	Amount of Surveys	Whom Surveyed	Whom p.d. for each Ch. & the Sur. Gen.l Acc.t
Township Lines	Tobias Wellett	June 26 1847	M. Ch. Lks. 47 77 00	4th Quar. 1848	
Subdivisions	Harvey Wells	Bond Sep. 20. 1852	60 06 48	3rd Quar. 1852	

The above Map of Township No. 40 N. of Range No. 25 West of the Principal Meridian Michigan is strictly conformable to the field notes of the Survey of the Sub-Divisions, as the same have been examined and approved by the Surveyor General's Office.

Charles Noble

Surveyor General's Office
Detroit Nov. 1st 1852

Charles Noble
Surveyor General