13-32

Re survey

Township No. 13 N. Range No. 1 W. Mer. Mich.

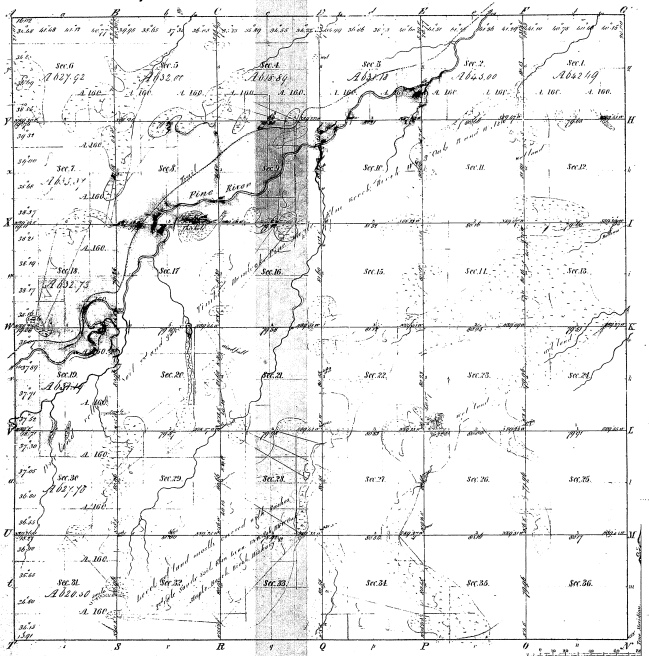

Those tracts that are shaded yellow are land that have been sold Nov 1853

Total number of Acres 22,415.57

Surveys Designated	By Whom Surveyed	Date of Contract	Amount of Surveys	When Surveyed	When Ap'd for and Ins'd in the Sur. Gen'l Ser'l
Township lines	Robert Clarkson	Nov 18 1830	18	38	4 Quar. 1831
Subdivisions	Austin Burt	Apr 1852	60	07	47 Quar. 1852

The above Map of Township No. 13 N. of Range No. 1 West of the Principal Meridian Michigan is strictly conformable to the field notes of the survey thereof on file in this Office, which have been examined and approved.

Surveyor General's Office
Detroit June 21 1853

Sean der Chapman
Sur. Gen'l

13-32