13-26

13-26

Township No. XIV N. Range No. II W. Mer. (Mich. Ter.)

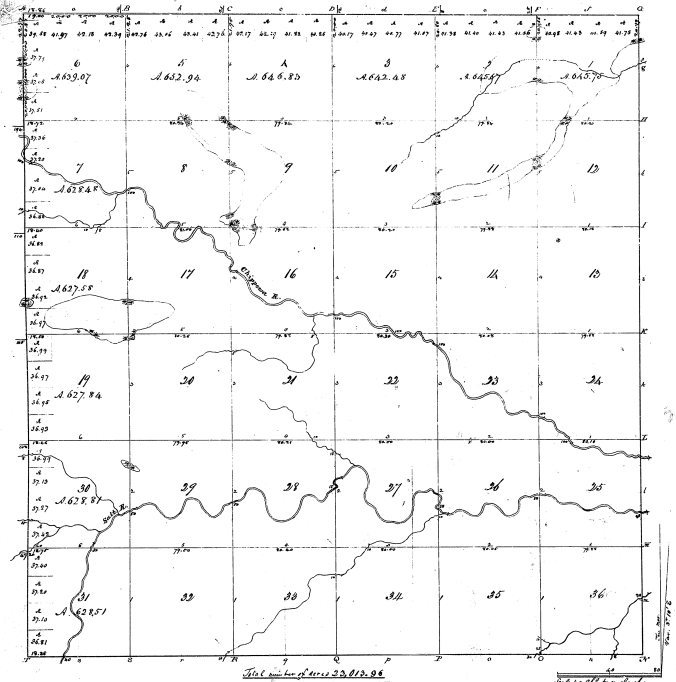

Total number of acres 23,013.96

Survey designated	By whom Surveyed	Date of Contract	Date of Survey	When Surveyed	When Approved
Original	Town boundaries	R. Clark	17 Nov. 1830		
	Subdivisions	Joel Wright	1 Dec. 1830	59.77.29	2d. Jan. 1832	3d. Jan. 1832

The above Map of Township No. 14 North of Range No. 2 West of Meridian Michigan Territory is strictly conformable to the Field Notes of the Survey thereof on file in this Office which have been examined and approved.

Surveyor General's Office
Cincinnati Ohio 24 Aug. 1832

M. T. McMeans
Surv. Genl.