Re-survey

Township. N.o 22 N. Range. N.o 7 W. Mer. Mich.

15-34

Meanders of

Prin.l Courses	Dist.s	Prin.l Courses	Dist.s

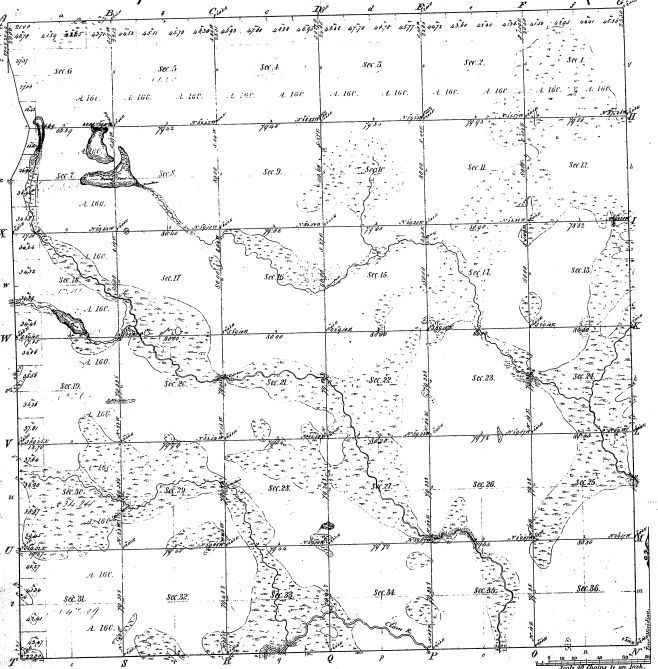

Total number of Acres 23 064 06

Surveys Designated.	By Whom Surveyed.	Date of Contract	Amount of Surveys	When Surveyed.	When for and at the Surr Gen.l use.
Township lines	Isaac Sutton	Nov.r 14.th 1832	M. 05 Ch. 41 L.s	2.d Quar.r 1837	
Subdivisions	W.m L. Coffinberry	April 22.d 1833	24 Mls. 1.0 Lks	2.nd & 3.d Quar.rs 1853	

The above Map of Township No. 22 N. of Range No. 7 W. of the Principal Meridian of Michigan is strictly conformable to the field notes of the survey thereof on file in this Office and is hereby examined and approved.

Surveyor Generals Office
Detroit January 25. 1854

Isaac Sutton
Surr Genl.