15-219

Reserved

Township. N.o 23 N. Range. N.o 5 W. Mer. Mich.

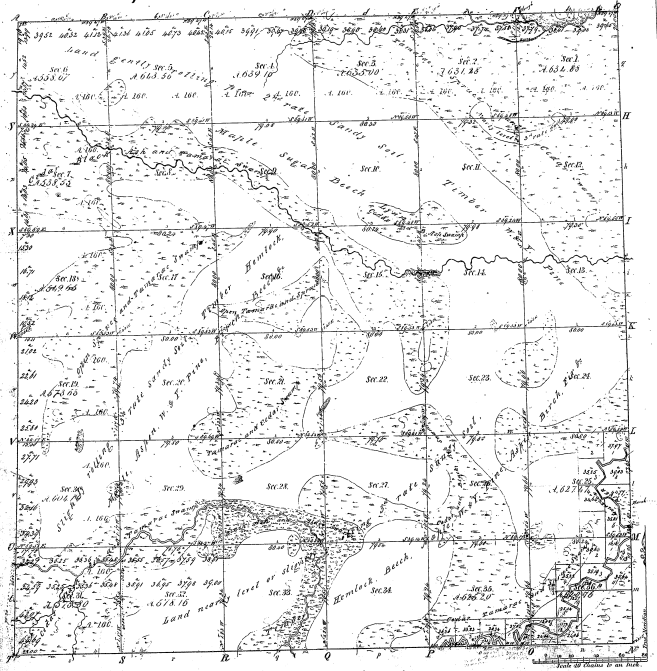

Meanders of
Pole Courses Ch's Lks | Pole Courses Ch's Lks | Pole Courses Ch's Lks

Total number of Acres. 22,475.96

Surveys Designated	By Whom Surveyed	Date of Contract	Journal of Surveys	When Surveyed	Whether to and what extent the Inst.ns were complied with
Township lines Subdivisions	John Brink. Belemas Carles	Nov.r 15 1836. April 20 1837.	1st 22 Dec.r 36 2d 22 Mch 37	3rd 4th Quars 1837.	

The above Map of Township N.o 23 N. of Range N.o 5 W. of the Principal Meridian of Michigan is strictly conformable to the field notes of the surveys thereof, on file in this office, which have been examined and approved.

Surveyor Generals Office
Detroit August 1 1838.

Saml Ludlow Surv.r Gen.l