Township No. VII South, Range No. VI East of Meridian

511

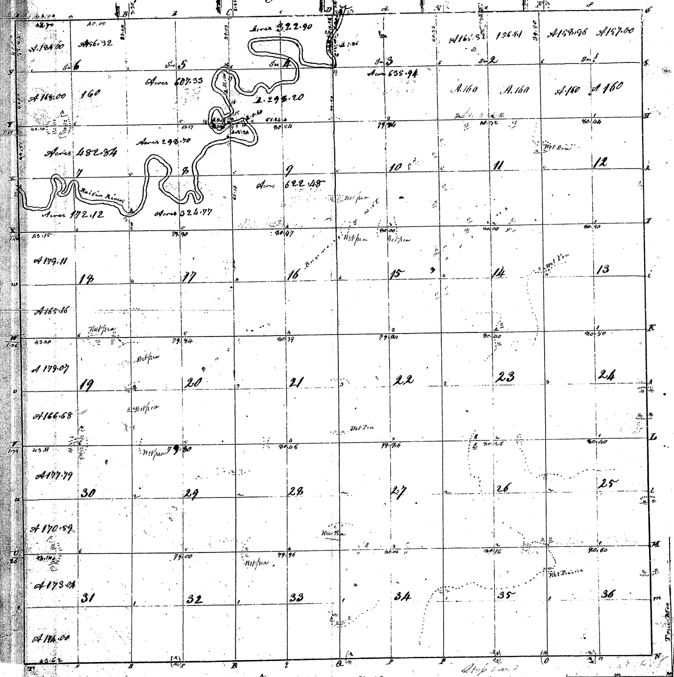

Total A 23.138.19

Pursuant to a contract with and instructions from Edward Tiffin Surveyor General of the United States bearing date the 20th day of April 1819 I have admeasured laid out and surveyed the above Township, and I do hereby certify that it had such marks and bounds both natural and artificial as are represented on said plat and described in the field notes made thereof and returned with this plat into the Surveyor General's Office.

Certified this 25th day of Sept. 1819

Joseph [illegible]

31-34