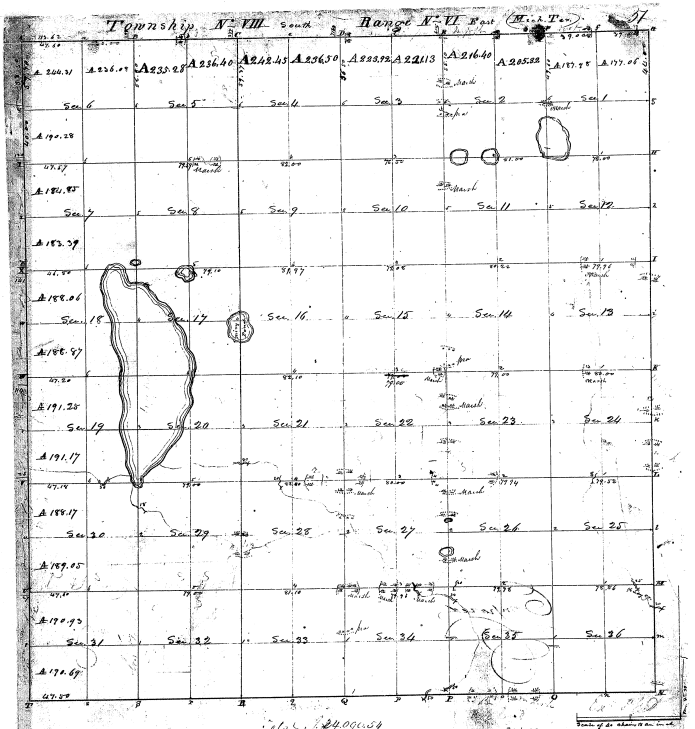

Pursuant to a Contract with and instructions from Edward Tiffin Surveyor General of the United States, bearing date the day of I have admeasured Said out and surveyed the Above Township, and do certify that the Red Marks and Lines both natural and Artificial as are represented on said plat and denoted in the field notes made thereof subscribed to with this plat are the Surveys Generals Office. Entered this 30 day of June 1820

Wm. Lee D. S.