


RESERVATION

Section	Area	Area	Area	Area	Area	Area
A 154.00	Sec 6	Sec 7	Sec 8	Sec 9	Sec 10	Sec 11

13th Reservation
 C. J. Davis
 Quantity and value of Reservation - \$1,010.96

Attest by this Original on file in this office,
 Surveyor General's office. June 18th 1885
 Charles T. Brown

Township N^o 9 S. Range N^o 6 E. Mer. (Mic)

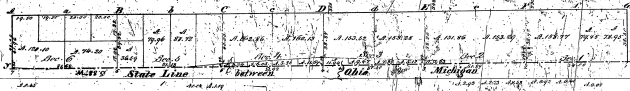

W. 1/2 Sec. 10
1-7-91

1/2 Sec. 10
1-7-91

State Mer.
1-7-91


Surveyed in 1831 by Joseph Thompson & others
Connection with State line in 1837 by John A. Smith & others

I certify that this is a true copy of the
original plat in this office.

Surveyor General's Office

Robert L. Smith