


Township No 9 N., Range No 6 West Mer. (Mich.)

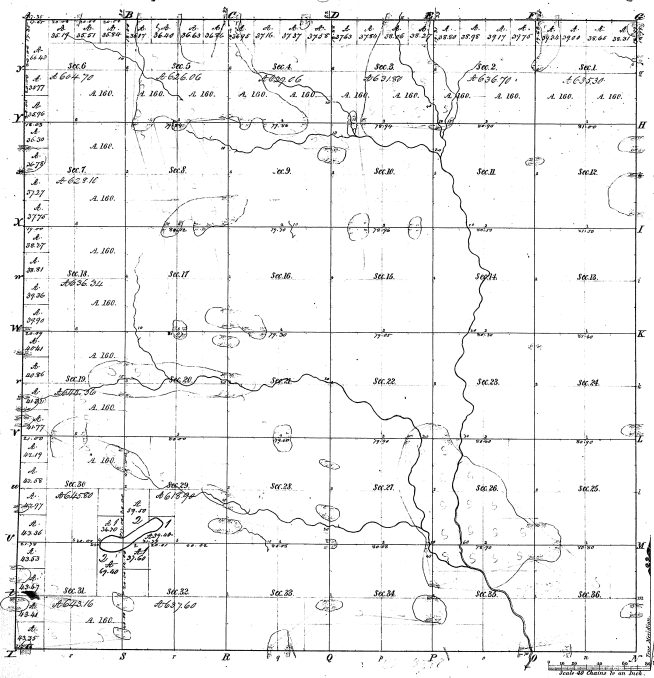

Boundaries of a Sub. in Northern Sp. 36, 37, 38

Sub. Course	1848	Sub. Course	1842	Sub. Course	1842

9-9

Total number of Acres 2373785


The above copy of Township No 9 North of Range No 6 West of this Principal Meridian Michigan is a true and correct copy of the survey thereof on file in this office, and has been examined and approved.

Surveyor General's Office

