


Township N<sup>o</sup> 12 N, Range N<sup>o</sup> 8 West Mer. (Mich.)

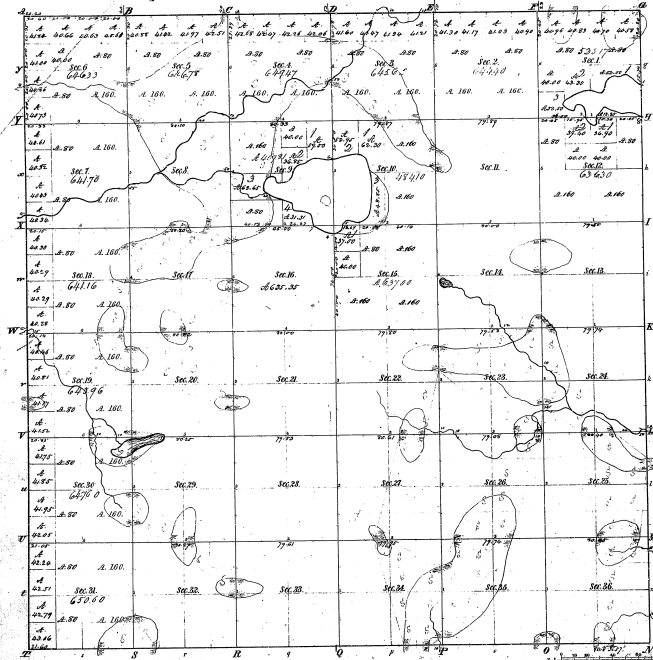

Members of Townships


Total number of Acres 20 643.35

Survey Designated	By Whom Surveyed	Date of Contract	Amount of Surveyed	When Surveyed


The above Map of Township N<sup>o</sup> 12 N, Range N<sup>o</sup> 8 West & Mer. of Mich. is a true and correct copy of the original survey and is approved by the Surveyor General for the State of Michigan.

Surveyor General's Office  
 Lansing, Mich. July 18 1837

July 12 1837

1837

Township 12 North Range 8 West Michigan

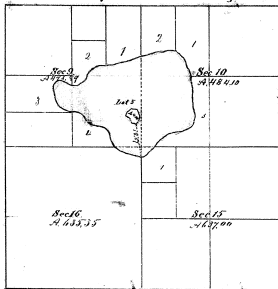

Meanders of Island	
4606	130
4166	250
1157	250
0908	400
5636	280
8108	220
8216	290
8676	220
8856	180

Surveyed by James W. Rankin Del. 20th  
on 24<sup>th</sup> of 22<sup>nd</sup> of 1855

General Land Office  

The above diagram of Island in Lake in Sec  
9, 10, 15 & 16 T. 12 N. R. 8 W. Michigan, is  
correctly conformable to the field notes and  
filed in the office which have been examined  
and approved

*J. J. Walker*  
Commissioner

263335