


Township 1° 29' N. Range 1° 2 E. Mer. Mich.

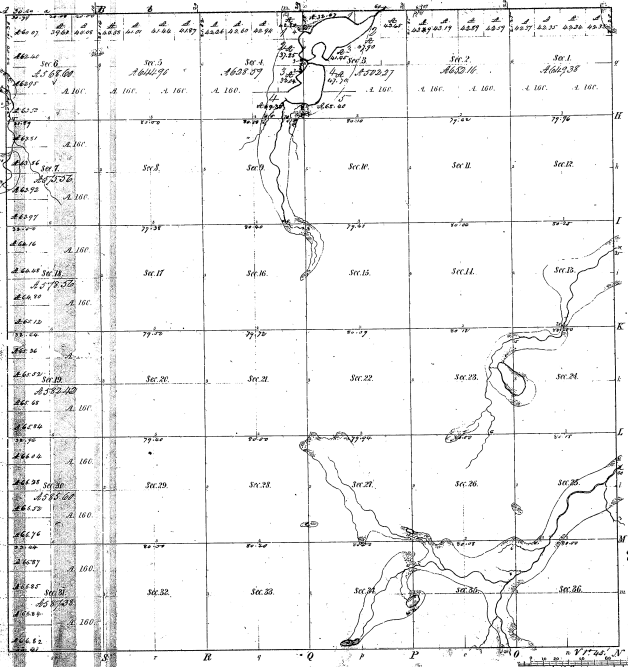





Survey	By Whom Surveyed	Date of Contract	Amount of Survey	When Surveyed	Where Surveyed

Original copy of Township 1° 29' N. of Range 1° 2 E. of the Principal Meridian, Michigan is hereby confirmed to all field notes of the survey thereof on file in this Office, which have been examined and approved.

Surveyor General's Office
 Grand Haven, Mich. 15th 1860

P. J. ...