Township No. 31 N. Range No. 1 E. Mer. Mich.

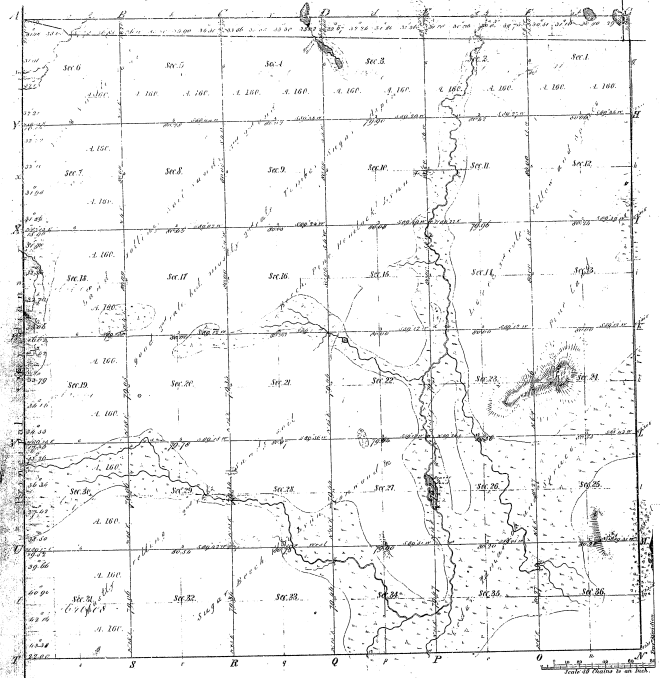

Meanders of												
Posts	Courses	Ch. Lks.	Posts	Courses	Ch. Lks.	Posts	Courses	Ch. Lks.	Posts	Courses	Ch. Lks.

20 28

Total number of Acres 22756.80

Surveys Designated	By Whom Surveyed	Date of Contract	Amount of Surveys	When Surveyed	When pt. Sec. and ch. in the Sur. Gen. Ls. acct.
Township Lines etc.	Austin Bird	April 19 1850	M. Chs. Lks.	2nd Quar. 1850	
Subdivisions	Austin Bird	April 19 1850	Sq. Lks. 16	2nd Quar. 1850	

The above Map of Township No. 31 North of Range No. 1 East of the Principal Meridian Michigan is strictly conformable to the field notes of the survey thereof on file in this Office which have been examined and approved.

Surveyor Generals Office
Detroit Dec. 23. 1850

Charles Noble Sur. Genl.