Township No. 9 N, Range No. 15 West Mer. (Mich.)

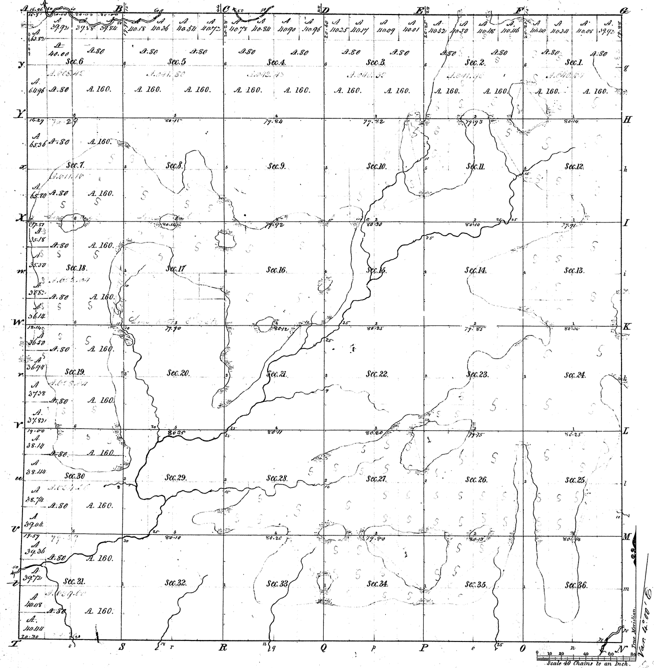

Total number of Acres 22,963.22

Surveys Designated	By Whom Surveyed	Date of Contract	Amount of Surveys (M. Chs. Lks.)	When Surveyed	When pd. for and chd. in the Sur. Gen.ls acct.
Township lines	N. Brookfield	31st Octr. 1836	23. 76. 24	2nd qr. 1837	3rd qr. 1838
Subdivisions	John Mullett	4th Jany. 1837	59. 71. 58	2nd qr. 1837	4th qr. 1837

The above Map of Township No. 9 North of Range No. 15 West of the Principal Meridian State of Michigan is strictly conformable to the field notes of the survey thereof on file in this Office, which have been examined and approved.

Surveyor Generals Office,
Cincinnati, Dec. 23rd 1837

E. S. Haines Sur. Genl.

Meanders of

Posts	Courses	Ch. Lk.	Posts	Courses	Ch. Lk.	Posts	Courses	Ch. Lk.

8-7