


March 11-1897

Township No 11 N., Range No 16 West Mer. (Mich)

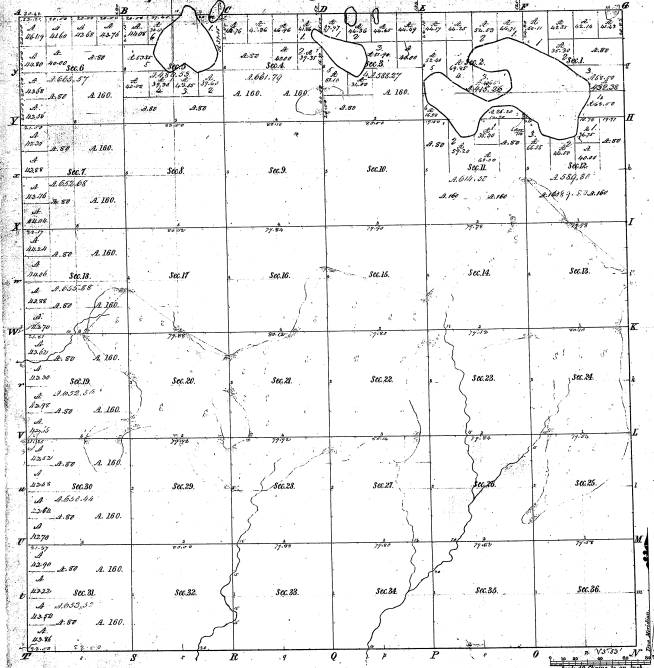

Mileage of several courses	
Course	Mileage
Course 1	1.1800
Course 2	1.1800
10-40

Total number of Acres 25,466.18			
Survey designated	By whom surveyed	Date of Survey	Amount of Survey
Township base	John W. Woodruff	25th Sept. 1846	36 25 1/2
Subdivisions	John Woodruff	25th Sept. 1846	57 47 7/8

The above map of Township 11 N. North of Range No 16 West of the Meridian, Michigan, is hereby confirmed to the following of the survey hereon file in the office which has been examined and approved.

Surveyor General's Office
 Michigan Dec. 25-1897

C. P. Pearson

2 Copies made
 11/25/97