


Township N. 12. N. Range N. 13. West Mer. (Michigan)

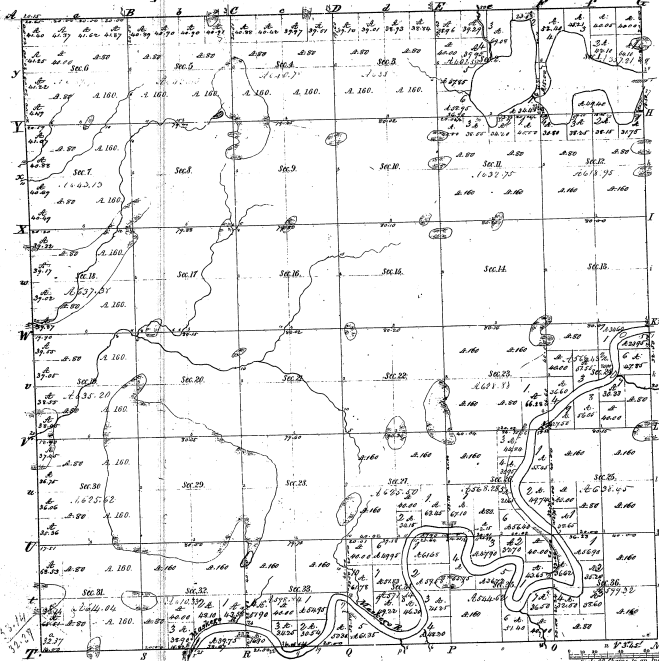


10-36

Total number of Acres 1297.11

Survey designated	By whom surveyed	Date of Contract	Amount of Survey	When Surveyed	When Surveyed	When Surveyed

The Mer. Map of Township N. 12. N. of Range N. 13. W. of the 6th Meridian ... is hereby approved by the ... of the survey being on file in this office, which has been examined and approved.

Surveyor General's Office
 Detroit, Michigan, 22/1/37

R. B. ...

