


Township No. 12 N. Range No. 14 West Mer. (Mich.)

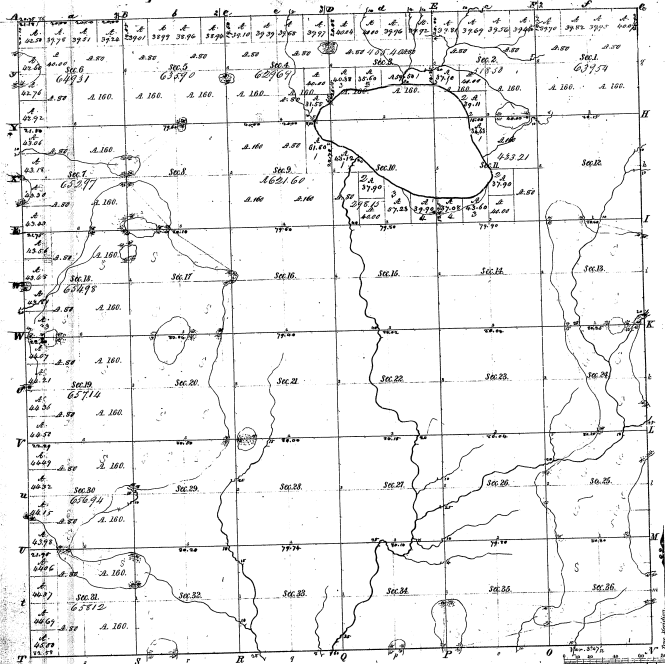




Total number of Acres 20,241.45



