Resurvey

Township N.o 14 N. Range N.o 13 W. Mer. Michigan

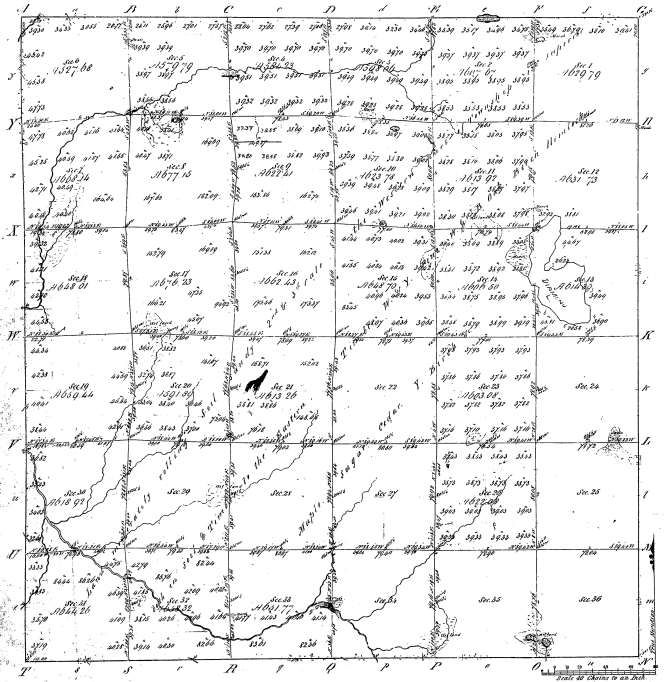

Total number of Acres 22,053.43

Surveys Designated.	By Whom Surveyed.	Date of Contract.	Amount of Surveys. M. Ch. Lks.	When Surveyed.	When Charged to the Surveyor General.
Township lines.	Millett & Brookfield	July 9th 1824	11 79 00	1st Quar. 1825	
Subdivisions	Millett. Office	May 8th 1826	86 76 27	4th Quar. 1826	

The above Map of Township N.o 14 North of Range N.o 13 West of the Principal Meridian of Michigan is strictly conformable to the field notes of the survey thereof on file in this Office, which have been examined and approved.

Surveyor Generals Office. Detroit March 30th 1827

Edward Mitchell Surv.r Gen.l

Meanders of

Posts	Courses	Dist Lks	Posts	Courses	Dist Lks	Posts	Courses	Dist Lks

Note. Note shaded yellow, sold prior to the resurvey

Meanders of Grand River

10-28