


Retracing and Resurvey

Township N<sup>o</sup> 14 N. Range N<sup>o</sup> 14 W. Mer. Mich.

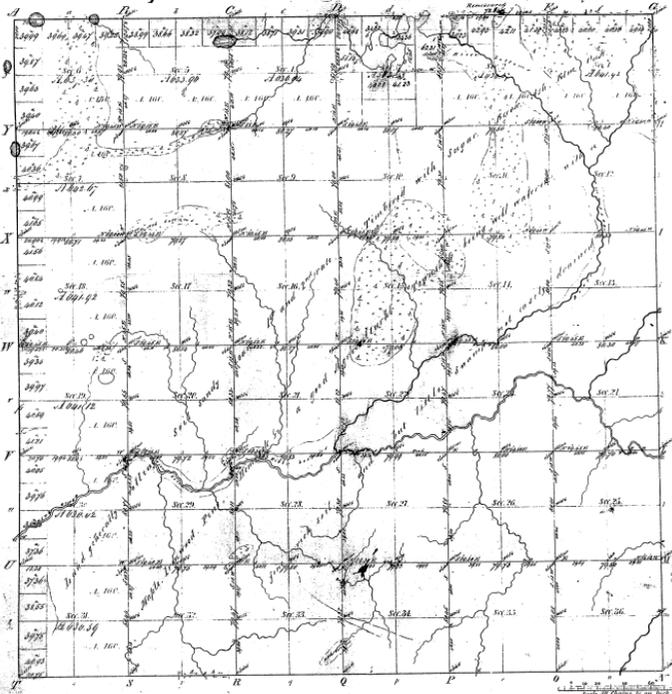

Measurements of  


10-21

10-21

Records of Sections of this Township.


Total number of Acres 22468.16

| Surveys Designated | By Whom Surveyed | Date of Contract | Amount of Survey | When Surveyed | How far from the true line |
|--------------------|------------------|------------------|------------------|---------------|----------------------------|

The above map of Township N<sup>o</sup> 14 N. Range N<sup>o</sup> 14 W. West of the Principal Meridian of T<sup>h</sup> State of Mich. is a true and correct copy of the original survey on file in the office which has been examined and approved.

Surveyor General's Office  

