Resurvey

Township No. 15 N. Range No. 13 W. Mer. Mich.

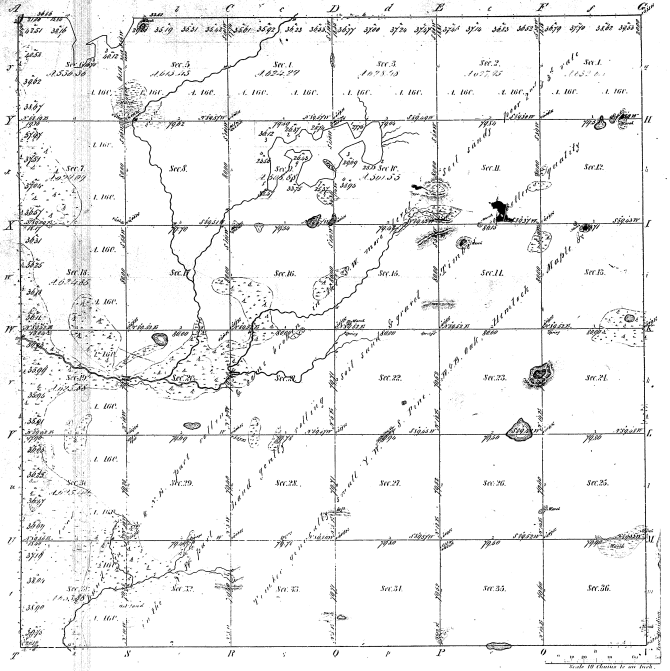

Meanders of								
Poals	Courses	Ch. Lks.	Poals	Courses	Ch. Lks.	Poals	Courses	Ch. Lks.

10-21

10-21

Total number of Acres 21,39,670

Surveys Designated	By Whom Surveyed	Date of Contract	Amount of Surveys	When Surveyed	When Ap.d for and Ap.d on the Ins. Gen.l
Township lines	Mulliet Brookfield	July 17th 1837	11 Chs 65 Lks	2nd Quar. 1838	
subdivisions	Milton Fyfe	May 6th 1840	65 Chs 54 Lks	3rd & 4th Quar. 1840	

The above Map of Township No. 15 North of Range No. 13 West of the Principal Meridian of Michigan is strictly conformable to the field notes of the survey thereof on file in this Office, which have been examined and approved.

Surveyor General's Office
Detroit, March 30th 1837

Leander Chapman
Sur. Gen.l