Resurvey

Township No. 16 N. Range No. 11 W. Mer. Mich.

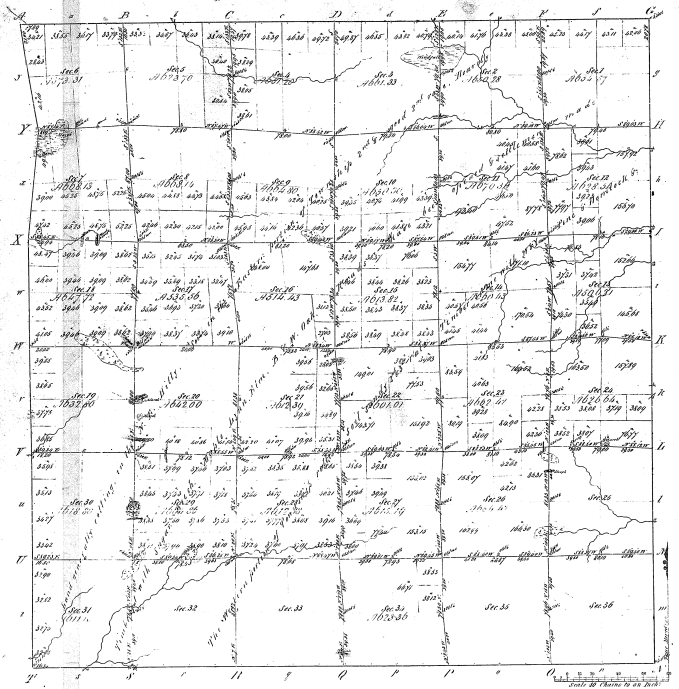

Meanders of								
Posts	Courses	Ch.s Lks	Posts	Courses	Ch.s Lks	Posts	Courses	Ch.s Lks

Note. Lots shaded yellow sold prior to the resurvey

Total number of Acres 22442.33

Surveys Designated.	By Whom Surveyed.	Date of Contract.	Amount of Surveys. M.	Ch.s	Lks	When Surveyed.	When Changed in one sur.y from the next
Township lines.	John Hodgson	June 12th 1837	11	77	13	4th Quar. 1838	
Subdivisions.	Milton Ayre	May 5th 1846	59	35	88	2nd & 3rd Quar. 1846	

The above Map of Township No. 16 North of Range No. 11 West of the Principal Meridian of Michigan is strictly conformable to the field notes of the survey thereof on file in this Office, which have been examined and approved.

Surveyor General's Office. Leander Chapman Sur.r Genl

Detroit. March 30. 1857

11-18