Resurvey

Township No. 16 N. Range No. 12 W. Mer. Mich.

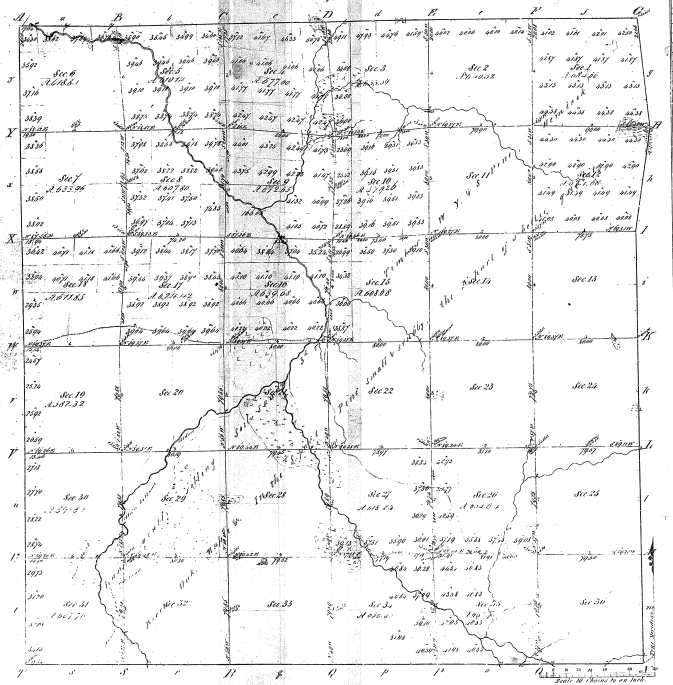

Meanders of								
Posts	Courses	Ch't Lk't	Posts	Courses	Ch't Lk't	Posts	Courses	Ch't Lk't

11-17

Note. Lots shaded yellow sold prior to the resurvey.

Total number of Acres

Surveys Designated.	By Whom Surveyed	Date of Contract.	Amount of Surveys M. Ch't Lk't	When Surveyed	When Changed in the Surv'ent Gen'l Acc't
Township lines.	John Hodgson	Jan'y 12th 1837	11 78 50	1st Quar. 1837	
Subdivisions.	Milton Jay	May 1st 1836	39 48 53	3d Quar. 1836	

The above Map of Township No. 16 North of Range No. 12 West of the Principal Meridian of Michigan is strictly conformable to the field notes of the survey thereof on file in this Office which have been examined and approved

Surveyor General's Office
Detroit March 30 1837

Leander Chapman Sur'r Genl